

Butler


KANSAS

SECTION 27 TOWNSHIP 28S RANGE 5E

WELL NO. #2 McLaughlin

COMPANY Shawver & Armour & CRA SE

NORTH SW SW NE

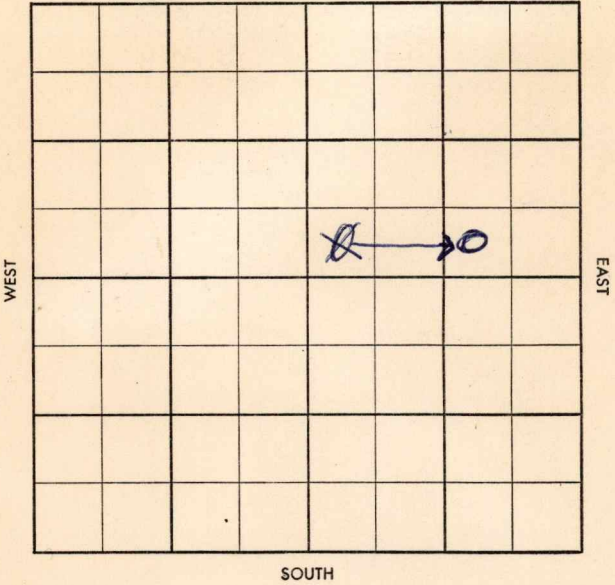

CORRECTION

29


6-513-B

County Butler Elev. 13470' / 13520'
 Sec. 27 Twp. 28 Rge. 5E
 Company Shawver & Armour and Co. R. A.
 Farm Name McLaughlin No. 2

TOPS	DEPTH	LOG	DATUM
Anh.			
Tp.			
H.			
Tr.			
Dg.			
B.L.			
L.			
K.C.	<u>2217</u>		
B.K. B. +	<u>2763</u>		
C. B. "	<u>2824</u>		
C.			
M.	<u>2825</u>		
M.			
K.			
Mz.			
Mq.			
V.			
S.			
S.			
A.			
R.			
Pf.			
G.			
T.D.	<u>2860</u>		

Loc. in Sec. SW SW NE app.
Let SW SW NE app.

Geol. _____
 Contr. _____
Shawver-Armour
 Pool _____
Fox-Bush

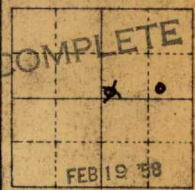

Date Comm. 1/20/58, 8" @ 200 w/120, Drlg. 320

Jan 29 '58 end 2766-96 rec

30' 15' good sd gso no log

5" 2858/25 FEB 5 '58 FEB 12 '58 FEB 19 '58

25/2789-93 6/2779-80

3/2765-66 18 FPH PB27B3

frac 3x3 5' 0 Boph + 30 Bwd

POP

25 B0 + 75 Bwd

Co

No.

Sec.

T.

z

29

County Butler Elev. _____
 Sec. 27 Twp. 28 Rge. 5E
 Company Shawver & Armour and C. R. A.
 Farm Name McLaughlin No. 2

TOPS	DEPTH	LOG	DATUM
Anh.			
Tp.			
H.			
Tr.			
Dg.			
B.L.			
L.			
K.C.			
B.K.C.			
Ce.			
C.			
M.			
M.			
K.			
Mz.			
Mq.			
V.			
S.			
S.			
A.			
R.			
Pf.			
G.			
T.D.			

Loc. in Sec. _____
SW SW NE app.

Geol. _____
 Contr. _____
Shawver-Armour

Pool _____
Fox-Bush

FIRST REPORT
 JAN 22 58

Date Comm. 1/20/58, 8" @ 200 w/120, Drlg. 320

Co.
Lst
No.
Sec.
T.
R.