


Butler

KANSAS

SECTION 27 TOWNSHIP 28S RANGE 5E

WELL NO. #1 Myers

COMPANY Cross Prod. Co.

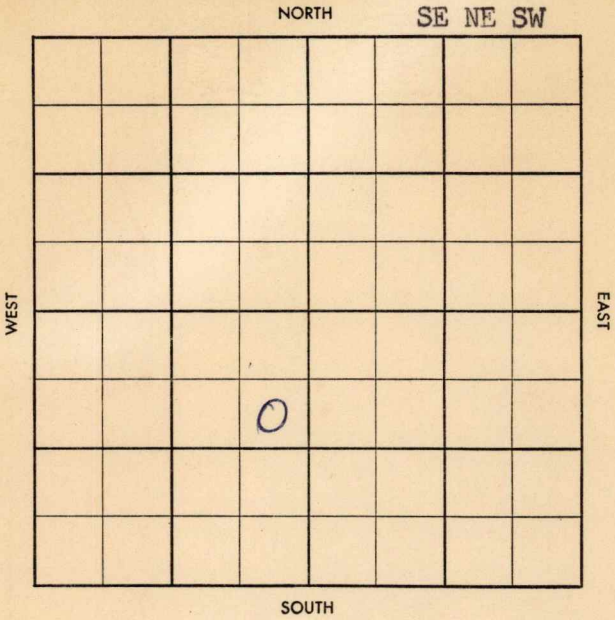

29

County Butler Elev. _____

Sec. 27 Twp. 28 Rge. 5E

Company Gross Prod. Co.

Farm Name Myers No. 1

TOPS	DEPTH	LOG	DATUM
Anh.			
Tp.			
H.			
Tr.			
Dg.			
B.L.			
L.			
K.C.			
B.K.C.			
Ce.			
C.			
M.			
M.			
K.			
Mz.			
Mq.			
V.			
S.			
S.			
A.			
R.			
Pf.			
G.			
T.D.			

Loc. in Sec. SE NE SW

Geol. _____

Contr. _____

Co. Tools _____

Pool Fox-Bush



Date Comm. 2/10/58

Drlg. 21

Co.

Lse.

No.

Sec.

T.

R.

Twp. ~~-----~~ Pool ~~-----~~
 Co. ~~-----~~ Facet ~~-----~~

S-513-B

County Butler Elev. 13350 - 13380
 Sec. 27 Twp. 28 Rge. 5E
 Company Gross Prod. Co.
 Farm Name Myers No. 1

TOPS	DEPTH	LOG	DATUM
Anh.			
Tp.			
H.			
Tr.			
Dg.			
B.L.			
L.			
K.C.	<u>22103</u>		
B.K.	<u>2776</u>		
Ce.			
C.			
M.			
M.			
K.			
Mz.			
Mq.			
V.			
S.			
S.			
A.			
R.			
Pf.			
G.			
T.D.	<u>2810</u>		

150' SECTION
SE NE SW
 Geol. _____
 Contr. _____
 Co. Tools _____
 Pool _____
Fox-Bush
 COMPLETE
 APR 9 '58

Date Comm. 2/10/58
 Drlg. 21 piposet 8" 200
nd 2767-94 no DST
5 1/2 2810 MAR 5 '58 MAR 12 '58 MAR 19 '58
MAR 26 '58 APR 2 '58 APR 9 '58 60/2776-94
\$ 830 80' BW pd pop
830 + 808W pd
B 2 h +

Co.
Lse.
No.
Sec.
T.
R.