




ELK

Map No. Kansas Sec. 22 Twp. 31 R. 10E

Well No. 4 Rorick Farm  
R. G. GILLESPIE Company

990 Ft. from N. Line  
..... Ft. from S. Line  
330 Ft. from E. Line  
..... Ft. from W. Line

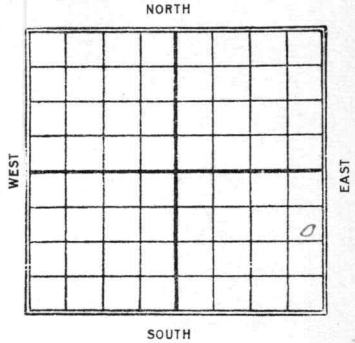

Date  
1927

REPORT

1/8 Sand 1641-1650 20 bbls  
 15 bbls from 1345-56  
 40 gts

*Edley*  
 31 R. 10 ✓

4 KANSAS  
 Map No. \_\_\_\_\_ Sec. *22* Twp. \_\_\_\_\_ R. \_\_\_\_\_  
 Well No. *4* *Hollick*

*R. G. Gillespie* \_\_\_\_\_ Company  
 \_\_\_\_\_ Contractor

FIRST REPORTS

SECTION PLAT

*990* Ft. from N. Line  
 \_\_\_\_\_ Ft. from S. Line  
*330* Ft. from E. Line  
 \_\_\_\_\_ Ft. from W. Line  
 COMPLETED

			0

Location \_\_\_\_\_  
 Rig up \_\_\_\_\_  
 Drilling and Remarks:  
*20 lbs*  


---

*had 15 lb well  
 from 1345-1356  
 was shot 40y*

RECORD  
 Cased *1641* in., *1650* ft.  
 Sand *1641-1650*  
 Gas \_\_\_\_\_  
 Oil \_\_\_\_\_  
 Total Depth *1650*

PRODUCTION  
 1st 24 hrs. Nat. \_\_\_\_\_  
 1st 24 hrs. after shot \_\_\_\_\_  
 Gas \_\_\_\_\_ Cu. Ft.  
 Dry Hole \_\_\_\_\_  
 Abandoned \_\_\_\_\_

Date \_\_\_\_\_  
 JAN 8 1927 *192* CHAS. L. SHERWOOD  
 \_\_\_\_\_ Scout