


Section 31 Township 28 Range 5E
Well No. 2 Bare "B"
Company White & Ellis

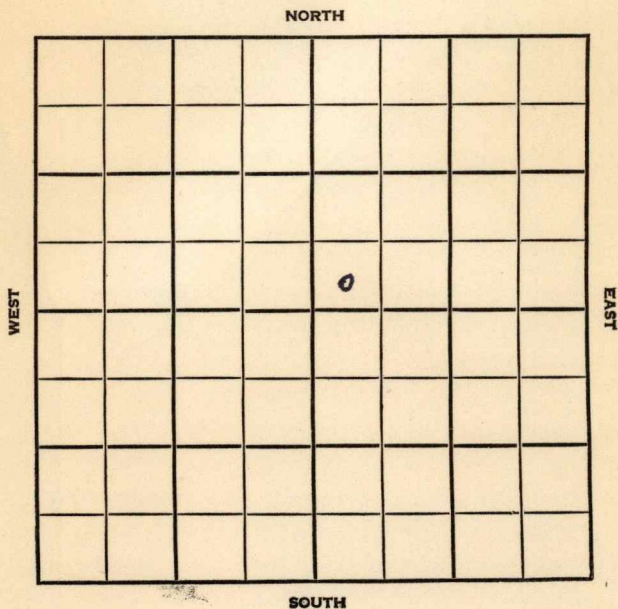

SEC.	TWP.	R.
31	28	5E

WELL NO.

2 Bare "B"

FARM

COMPANY

White & Ellis

CONTRACTOR

Co. Tools


Bare Pool

_____ Ft. from N. Line

330 _____ Ft. from S. Line

_____ Ft. from E. Line

330 _____ Ft. from W. Line

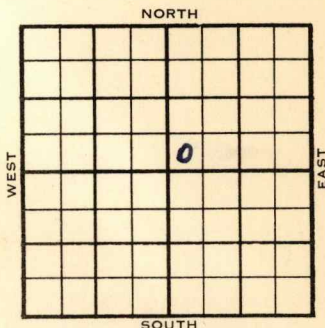

SW SW NE
Texas FO

	ELEVATION	REPORT
1954	-	

11/10

Spud 10-26-54

D&A

TD 2900'

8" @ 95'

KC 2245', Bart 2764',

Core 2760-92

Miss 2850'


TD 2900'

D&A

FIRST REPORT

ABANDONED

County Butler State Kansas
 Sec. 31 (Blk. 28 (Sur. 5E Map No.
 (Twp.) (Rge.)
 Operator White & Ellis
 Well No. 2 Farm Bare "B"
 Elev. Location SW SW NE

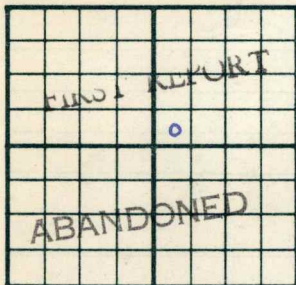

330 Ft. From S Line NE
330 Ft. From W Line Quarter
 1st. Report NOV 10 1954
 Completion NOV 10 1954
 Remarks Texas farmout
Co. tools
 Spudding Date 10-26-54

Drlg. Data D & A TD 2900 Bare Pool
8" @ 95 KC 2245 Bart. 2764
Core 2760-92 Miss. 2850 TD 2900

D & A

FABEN GILSTRAP