


Section 31 Township 28 Range 5^E

Well No. 1 Cousins

Company Saco

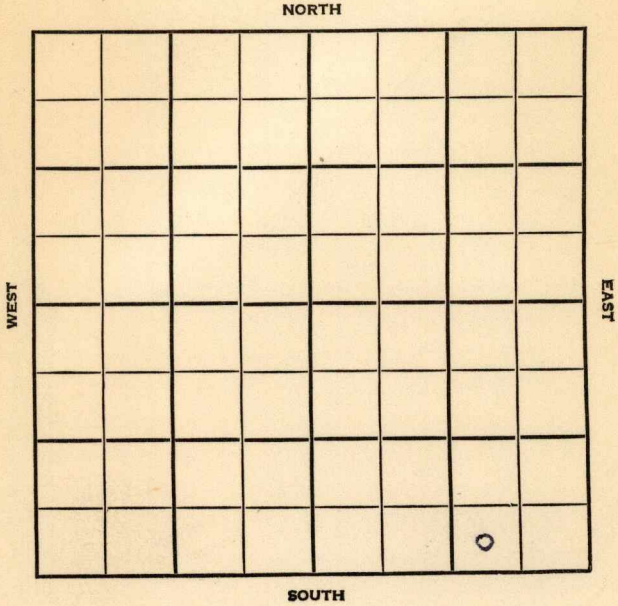

SEC.	TWP.	R.
31	28	5E


WELL NO. **1 Cousins** FARM

COMPANY **Saco**

CONTRACTOR **Co. Tools**

Bare Pool

_____ Ft. from N. Line
330 _____ Ft. from S. Line
990 _____ Ft. from E. Line
 _____ Ft. from W. Line

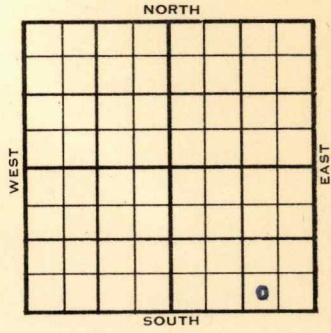

SW SE SE

	ELEVATION	REPORT
1954	1301'	

9/22

MICT

10/27

Spud 9-22-54 D & A TD 2869
 15" @ 111 13" @ 941 10" @ 1616
 Lans. 1845 KC 2226 Bart 2790
 TD 2869 D & A

ABANDONED

