


Section 31 Township 28 Range 5E

Well No. #1 Schaul

Company Rex & Morris

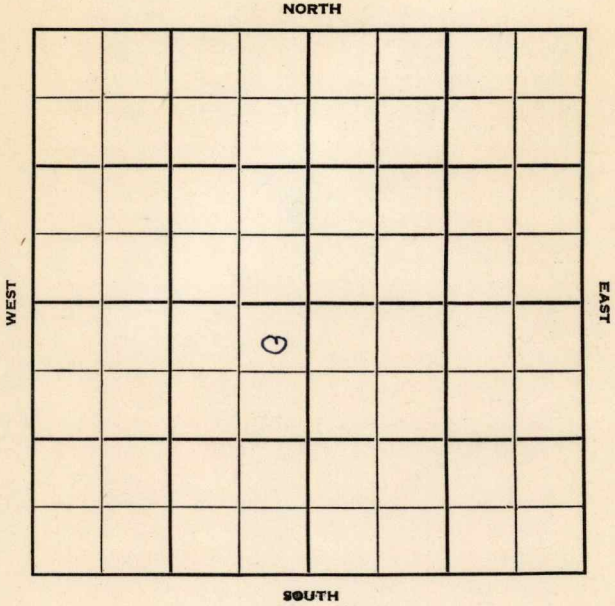

Sec. 31 Twp. 28 R. 5E

Well No. #1 Schaul Farm

Rex & Morris Company

Contractor

Wildcat


330 Ft. from N. Line

Ft. from S. Line

330 Ft. from E. Line

Ft. from W. Line

NE NE SW

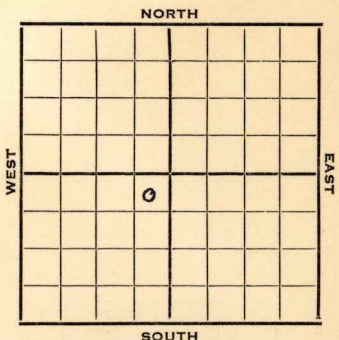

1952

Elev. 1297 REPORT

8/20 Spud 8-17-52
8" @ 108' Drlg.

9/4 Spud 8-17-52
Oil Well TD 2864
8" @ 108
Bart 2794 TD 2798
5" @ 2794 Miss 2855
DD 2864 PB 2800
S-frac S/13 bo
Comp. 20 bopd

COMPLETED

County **Butler** State **Kansas**

Sec. **31** (Blk. Twp.) **28** (Sur. Rge.) **5E** Map No.

Operator **Rex & Morris**

Well No. **1** Farm **Schaul**

Elev. Location **NE NE SW**

FIRST REPORT

0

330 Ft. From **N** Line **SW**

330 Ft. From **E** Line Quarter

1st. Report **AUG 20 1952**

Completion

Remarks

Spudding Date **8-17-52**

Drlg. Data **Wildcat**

8" @ 108 Drlg.

J. G. McGENEE