


Elk

Map No. KANSAS Sec. 22 Twp. 31 R. 10^E

Well No. 5 Rorick Farm
Superior Oil & Gas Company

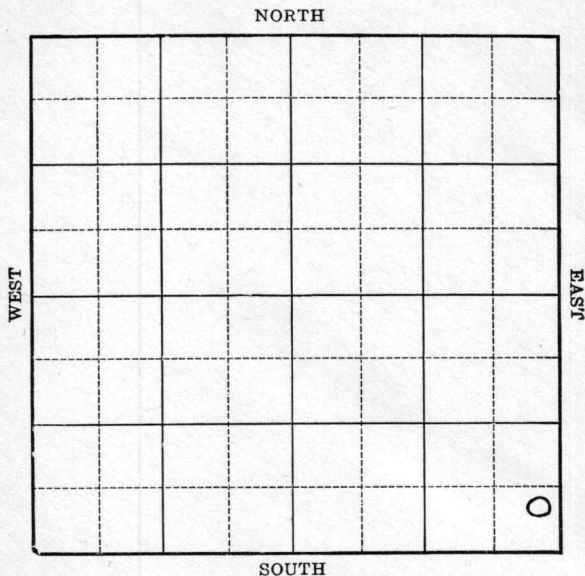

Location _____
Drilling Remarks _____

Rig Up _____
Drilling Remarks _____

RECORD

Cased _____ in. _____ ft.
Sand _____
Gas _____
Oil _____
Total Depth _____

PRODUCTION

1st 24 hrs. Nat. _____
1st 24 hrs. after shot _____
Gas _____ cu. ft.
Dry Hole _____
Abandoned _____

Elk

Map No. KANSAS Sec. 22 Twp 31 R. 10^E

Well No. 5 Rarick Farm


Superior Oil & Gas Company

 Ft. from N. Line

660 Ft. from S. Line

200 Ft. from E. Line

 Ft. from W. Line

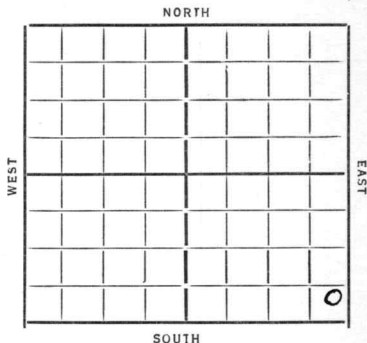

Date
1934

REPORT

2/7 Machine
2/17 Spud.
2/23 12" at 265
3/1 Drly 700 10" 509
3/14 KC Lime 1300 7D 1344
1000 Gal acid 60 Bbls.

COMPLETED

Map No. 4 Sec. 22 Twp. 31 R. 10E

Well No. 5- Raink

Superior Oil & Gas Company

Contractor

FIRST REPORTS

Ft. from N. Line

600 Ft. from S. Line

200 Ft. from E. Line

Ft. from W. Line

SECTION PLAT

Location

Rig up

Drilling and Remarks:

Machine

RECORD

Cased.....in.,ft.

Sand.....

Gas.....

Oil.....

Total Depth.....

PRODUCTION

1st 24 hrs. Nat.....

1st 24 hrs. after shot.....

Gas.....Cu. Ft.

Dry Hole.....

Abandoned.....

Date

2-7-34 192 O. Mammescheub Scout

Map No. 4 Sec. 22 Twp. 31 R. 102

Well No. 5-Barick

Superior oil Company

Contractor

COMPLETED

SECTION PLAT

Ft. from N. Line

600 Ft. from S. Line

200 Ft. from E. Line

Ft. from W. Line

			0

Location

Rig up

Drilling and Remarks:

1000 gal oil

60 lbs

RECORD

Cased in, ft.

Sand KC line 1300

Gas

Oil

Total Depth 1344

PRODUCTION

1st 24 hrs. Nat.

1st 24 hrs. after shot

Gas Cu. Ft.

Dry Hole

Abandoned

Date

3-14-34 192 O. Manschuet Scout