




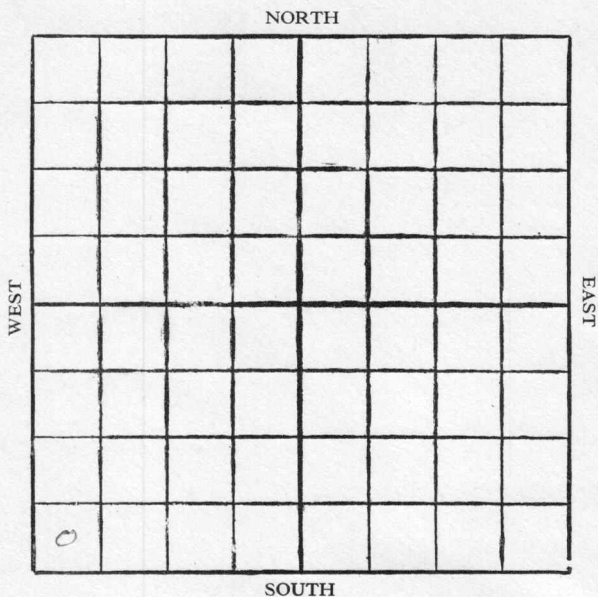

Location

Drilling Remarks

.....

.....

RECORD

Cased..... in. ft.

Sand

Gas

Oil

Total Depth.....

Rig Up.....

Drilling Remarks

.....

.....

PRODUCTION

1st 24 hrs. Nat.....

1st 24 hrs. after shot.....

Gas..... cu. ft.

Dry Hole.....

Abandoned.....

4 KANSAS 23 Twp. 31 R. 10^W
Map No. Sec. Twp. R.

Well No. *Wells*
Shelby Oil Co
Company

Contractor

FIRST REPORTS

SECTION PLAT

Ft. from N. Line

330

Ft. from S. Line

Ft. from E. Line

330

Ft. from W. Line

COMPLETED

<i>0</i>			

Location

Rig up

Drilling and Remarks:

150 ft

*had 50 ft well
from 1300-1336
was shot 40y*

RECORD

Cased *1603-1620* in., ft.

Sand

Gas

Oil

Total Depth *1620*

PRODUCTION

1st 24 hrs. Nat.

1st 24 hrs. after shot

Gas Cu. Ft.

Dry Hole

Abandoned

Date

JAN 8 1927

CHAS. L. SHERWOOD

192

Scout