

KANSAS

FORM 51 5M 10-41 PETROL

Butler

Section 33 Township 28 Range 5-E

Well No. #1 Manning

Company Ash & Ritchie

NORTH Miscellaneous

SOUTH

WEST EAST

KANSAS

Butler

Sec. 33 Twp. 28 R. 5-E

Well No. #1 Manning Farm

Ash & Ritchie Company


(Misc.)

 Ft. from N. Line

660 Ft. from S. Line

 Ft. from E. Line

990 Ft. from W. Line

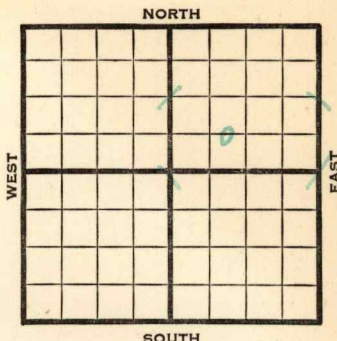

1942

REPORT

4/15

Rotary.

4/22

"

4/29

8" - 377' Drlg. 2638'

5/6

Bart. 2777-80' T.D. 5" - 2776' RUST.

5/13

Bart. 2777'

B. Bart. 2789'

T.D. 2791'

H.F.W.

ABANDONED

Butler

KANSAS

Map No. 11 Sec. 33 Twp. 28 R. 5EWell No. 1 ManningAsh & Ritchie


Company

FIRST REPORT

Contractor

C E L S W N E

SECTION PLAT

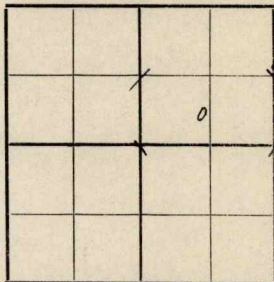

Ft. from N. Line

660

Ft. from S. Line

Ft. from E. Line

990

Ft. from W. Line

MISCELLANEOUS

Location _____

Rig up _____

Drilling and Remarks:

Rotary

RECORD

Cased _____ in., _____ ft.

Sand _____

Gas _____

Oil _____

Total Depth _____

PRODUCTION

1st 24 hrs. Nat. _____

1st 24 hrs. after shot _____

Gas _____ Cu. Ft.

Dry Hole _____

Abandoned _____

Date

APR 15 1942

19

S. J. LEWIS

Scout

KANSAS

Butler

Map No. 11 Sec. 33 Twp. 28 R. 5EWell No. 1 ManningAsh & Ritchie

Company

ABANDONED

Contractor

C E L S W N E

SECTION PLAT

 Ft. from N. Line660 Ft. from S. Line Ft. from E. Line990 Ft. from W. Line

MISCELLANEOUS

Location Rig up

Drilling and Remarks:

*Bar 82777**A. Bar 82789**XFW.*

RECORD

Cased in., ft.Sand Gas Oil Total Depth 2791

PRODUCTION

1st 24 hrs. Nat. 1st 24 hrs. after shot Gas Cu. Ft.Dry Hole Abandoned

Date

MAY 13 1942 19S. J. LEWIS

Scout