


Section 25 Township 31 Range 10-E

Well Number 2 Cochran

Company Diller G&G

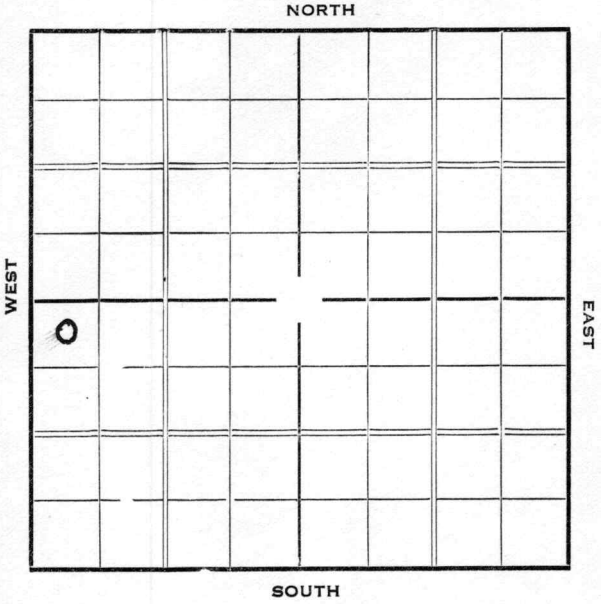

Sec. 25 Twp. 31 R. 10-E


Well No. #2 Cochran Farm
Diller O & G Company

330 Ft. from N. Line

_____ Ft. from S. Line

_____ Ft. from E. Line

330 Ft. from W. Line

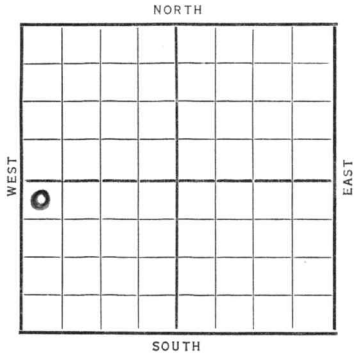

Date	REPORT
3/3	Location
3/11	Spud
3/18	Shut Down
3/25	10" @ 728'. Drlg. 1925'.
4/2	Mississippi Lime. 1998' Drlg.
	2272'.
4/8	Shut Down
4/16	" "
4/21	Sil. 2281'.
	T.D. 2283'.
	Potential 50.
	COMPLETED

Map No. 4 Sec. 25 Twp. 31 R. 10E

Well No. 2 Cochran

Diller O & G. Company

Contractor

SECTION PLAT

0			

320 Ft. from N. Line

_____ Ft. from S. Line

_____ Ft. from E. Line

320 Ft. from W. Line

FIRST REPORT

Location ✓

Rig up _____

Drilling and Remarks: _____

RECORD

Cased _____ in., _____ ft.

Sand _____

Gas _____

Oil _____

Total Depth _____

PRODUCTION

1st 24 hrs. Nat. _____

1st 24 hrs. after shot _____

Gas _____ Cu. Ft.

Dry Hole _____

Abandoned _____

Date

MAR 3 1937 19

S. J. LEWIS Scout

KANSAS *Elk*

Map No. 4 Sec. 25 Twp. 31 R. 10E

Well No. 2 Cochran

Jiller O & G. Company

Contractor

SECTION PLAT

0			

330 Ft. from N. Line

_____ Ft. from S. Line

_____ Ft. from E. Line

330 Ft. from W. Line

COMPLETED

Location _____

Rig up _____

Drilling and Remarks:

Sil 2281

Potential

50

RECORD

Cased _____ in., _____ ft.

Sand _____

Gas _____

Oil _____

Total Depth 2283

PRODUCTION

1st 24 hrs. Nat. _____

1st 24 hrs. after shot _____

Gas _____ Cu. Ft.

Dry Hole _____

Abandoned _____

Date

APR 21 1937

19

S. J. LEWIS Scout