



ELK

Map No. Kansas Sec. 25 Twp. 31 R. 10<sup>E</sup>


Well No. 1 Key Farm  
Frazier et al Company

..... Ft. from N. Line

200 Ft. from S. Line

..... Ft. from E. Line

660 Ft. from W. Line

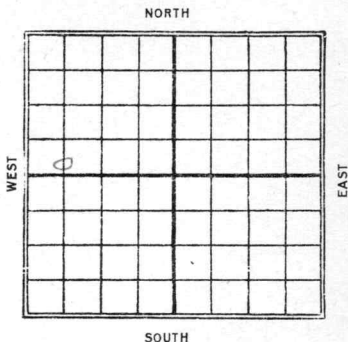

Date

REPORT

1927

1/8 Sand 1416-1423  
Top Line 1985  
1st break 1995-2010  
T.D. 2035 1/4 m Gas

4 KANSAS 25 6615 31 10<sup>W</sup>  
Map No. Sec. Twp. R.

Well No. 1 Key

Fraser et al Company

Contractor

FIRST REPORTS

SECTION PLAT

Ft. from N. Line

200

Ft. from S. Line

Ft. from E. Line

660

Ft. from W. Line

COMPLETED

o			

Location

Rig up

Drilling and Remarks:

TH 1985  
1st Breaks gas 1995-  
2010  
Sgs well

RECORD

Cased in. ft.

Sand 1416-1423

Gas

Oil

Total Depth 2035

PRODUCTION

1st 24 hrs. Nat.

1st 24 hrs. after shot

Gas 1/4 M Cu. Ft.

Dry Hole

Abandoned

Date

JAN 8 1927

CHAS. L. SHERWOOD

192 Scout