

Sec. 9

Twp.

R.

—

Farm

Mathews & Co. Company

Q

WEST

EAST

SOUTH

COMPLETED

Rig Up-----

Drilling Remarks:

RECORD

1st 24 hrs. Nat. -----

1st 24 hrs. after shot-----

Gas -----cu. ft.

Dry Hole-----

Total Depth -----

Abandoned_ _ _ _ _

Map No. _____ Sec. 34 Twp. 28 R. 5


Well No. #1 Tool Farm
Matthews et al Company

200 Ft. from N. Line

_____ Ft. from S. Line

_____ Ft. from E. Line

1120 Ft. from W. Line

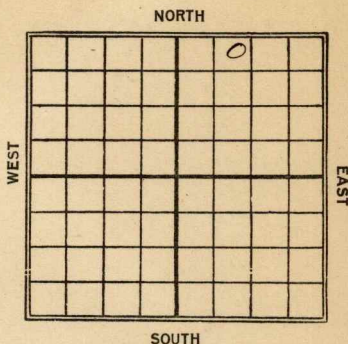

Date _____

REPORT

Date 1922

7/2	2
-----	---

9/16	D. & Q. 2825
------	--------------

Pig

Map No. Kans 34 Sec. 28 Twp. 5 R. 5

Well No. 1 Boal

Mathews et al Company

Contractor

FIRST REPORT

200 Ft. from N. Line

_____ Ft. from S. Line

_____ Ft. from E. Line

120 Ft. from W. Line

SECTION PLAT

Location _____

Rig up _____

Drilling and Remarks:

Rig.

RECORD

Cased _____ in., _____ ft.

Sand _____

Gas _____

Oil _____

Total Depth _____

PRODUCTION

1st 24 hrs. Nat. _____

1st 24 hrs. after shot _____

Gas _____ Cu. Ft.

Dry Hole _____

Abandoned _____

Date

JUL 22 1922

M. A. BENEAR

191

Scout

Map No. **KANSAS** Sec. **34** Twp. **28** R. **3**Well No. **1200****Mathews et al** Company

Contractor

ABANDONED

SECTION PLAT

		0	

200 Ft. from N. Line

Ft. from S. Line

Ft. from E. Line

1120 Ft. from W. Line

Location

Rig up

Drilling and Remarks:

RECORD

Cased in., ft.

Sand

Gas

Oil

Total Depth

PRODUCTION

1st 24 hrs. Nat.

1st 24 hrs. after shot

Gas Cu. Ft.

Dry Hole

Abandoned **2723**

Date

SEP 16 1922

191

M. A. BENEAR

Scout