


Section 35 Township 28 Range 5E

Well No. #1 Brown

Company White & Ellis

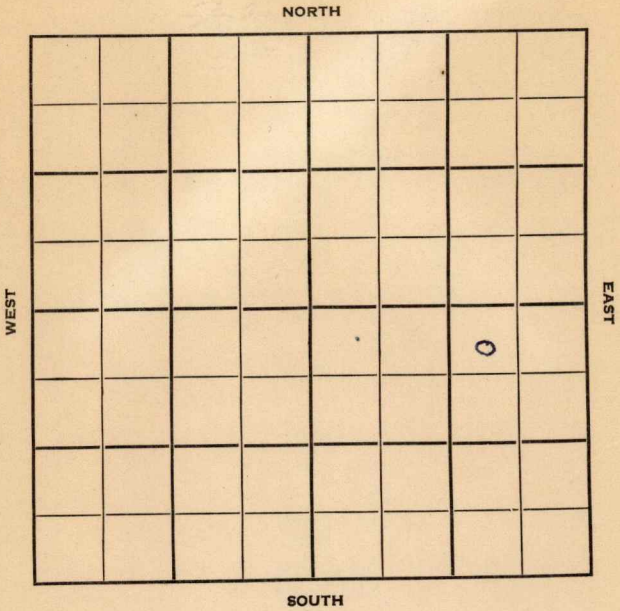

Butler

KANSAS

Sec. 35 Twp. 28 R. 5E

Well No. #1 Brown Farm

White & Ellis Company

Contractor


330 Ft. from N. Line

Ft. from S. Line

990 Ft. from E. Line

Ft. from W. Line

SE 1/4 NW NE SE

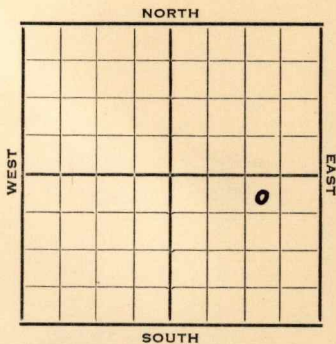

7952 Elev. 1326' REPORT

10/22 Bart 2755'
TD 2814'
5" @ 2809'

11/12 Oil Well
TD 2817'
Bart 2755
TD 2814
5" @ 2776
DD 2817 w tr
PB 2801
30/2754-64, 15/2771-76,
21/2785-99, 4 gwph & SSO
Hydro
Comp. 10 bopd 10 bw

COMPLETED

