


Butler

KANSAS

SECTION 35 TOWNSHIP 28S RANGE 5E

WELL NO. #2 Clark "B"

COMPANY Morrison

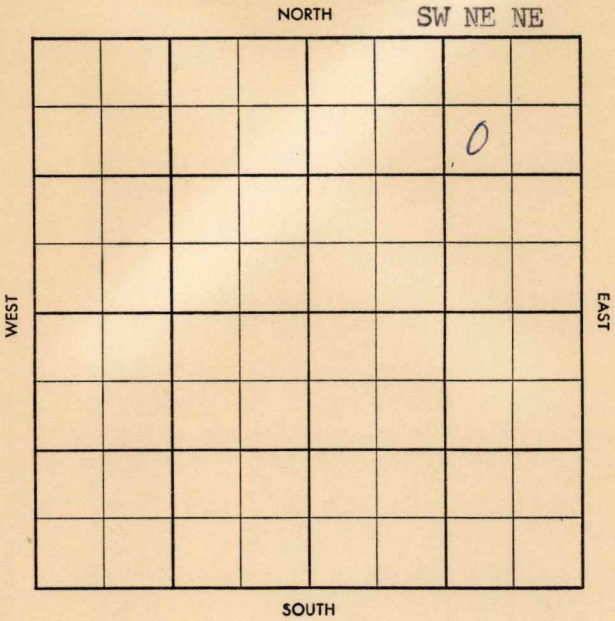

29

S-513-A

CO. ~~Butler~~ ELEV. 1326
SEC. 35 TWP. 28 RGE. 5E
COMPANY Morrison No. 2

DEC 11 '57

ABANDONED

FARM Clark "B"

Twin

LOC. SW NE NE

GEOL.
CONTR. Glen Gaines tools
POOL Fox-Bush
SPUD 11/24/57
8" @ 110 w/70, ϕ 2785-
2803, full rec, ϕ 3
2803 -?. (no tops picked
yet.) Oil well in wtr.
flood project. DEC 11 '57

KC 2132

U Bant 2 2698 - 2709
N 05d M chat 2807
RTD 2812

D 6 A

CO.
LSE.
NO.
SEC.
TWP.
RGE.