

Map No. 2 Sec. 35 Twp. 28 R. 5

Well No. 56 Clark Farm
White Star Oil Company

NORTH

WEST

EAST

SOUTH

Location _____

Drilling Remarks:

RECORD

Cased _____ in. _____ ft.

Sand _____

Gas _____

Oil _____

Total Depth_____

Rig up _____

Drilling Remarks:

PRODUCTION

1st 24 hrs Nat. _____

1st 24 hrs. after shot_____

Gas _____ cu. ft.

Dry Hole_____

Abandoned _____

Map No. _____ Sec. 35 Twp. 28 R. 5


Well No. 5 Clark Farm _____
White Star Oil Company _____
Was & S. Oil

_____ Ft. from N. Line

960 Ft. from S. Line

200 Ft. from E. Line

_____ Ft. from W. Line

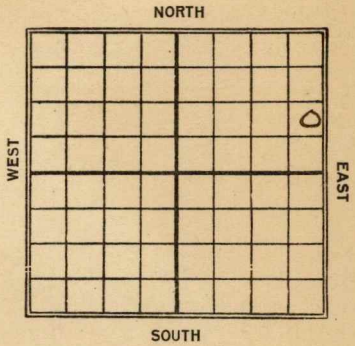

Date	REPORT
1/23	
3/22	Dg. 1375'
4/20	Sand 2739-89- Shot 40 qts. 35 Bbls.

Map No. **KANSAS** 11 Sec. 35 Twp. 28 R. 5

Well No. 56 Clark

white star oil Company

was S & S oil Co Contractor

FIRST REPORT

SECTION PLAT

			o

Ft. from N. Line

960 Ft. from S. Line

200 Ft. from E. Line

Ft. from W. Line

Location

Rig up

Drilling and Remarks:

Qty - 1375

RECORD

Cased _____ in., _____ ft.

Sand _____

Gas _____

Oil _____

Total Depth _____

PRODUCTION

1st 24 hrs. Nat. _____

1st 24 hrs. after shot _____

Gas _____ Cu. Ft.

Dry Hole _____

Abandoned _____

Date

MAR 22 1923

M. A. BENEAR

192

Scout

Map No. **KANSAS** 11 Sec. 35 Twp. 28 R. 5Well No. 5 *Clark*
White Star Oil Co Company

Contractor

COMPLETED

SECTION PLAT

			0

Ft. from N. Line

960 Ft. from S. Line

300 Ft. from E. Line

Ft. from W. Line

RECORD

Location

Cased _____ in., _____ ft.

Rig up

Sand

Drilling and Remarks:

Gas

Oil

Total Depth

PRODUCTION

1st 24 hrs. Nat.

1st 24 hrs. after shot

Gas _____ Cu. Ft.

Dry Hole

Abandoned

Date

APR 20 1923

M. A. BENEAR

191

Scout