

ELK

Form 252-A
5M 4-32 MPC

KANSAS

Map No. _____ Sec. 26 Twp. 31 R. 10^E

Well No. 1-Hull Farm _____


Central States Company _____

330 Ft. from N. Line

_____ Ft. from S. Line

660 Ft. from E. Line

_____ Ft. from W. Line

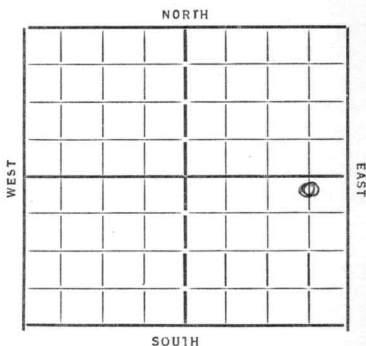

Date

REPORT

1933	
3/15	Drilling 150
3/22	S.D. 150'
3/29	—
4/4	S.D. 200'
4/12	drly 750'
4/19	set 10" 720'
4/26	drly 890'
5/4	8" 1335'
5/10	6" 1340 S.D.
5/17	—
5/24	Sand 1545-92
	show oil 2 bbls
	Oswego line 1665-92
	T. D. 1710
	Abandoned 1710'
	(Completed)

ELK

E

Map No. 4 **KANSAS** Sec. 26 Twp. 31 R. 10

Well No. 1 Hull

Central States Oil Co Company

Contractor

FIRST REPORTS

SECTION PLAT

330 Ft. from N. Line

..... Ft. from S. Line

660 Ft. from E. Line

..... Ft. from W. Line

			o

Location.....

Rig up.....

Drilling and Remarks:

RECORD

Cased.....in.,ft.

Sand.....

Gas.....

Oil.....

Total Depth.....

PRODUCTION

1st 24 hrs. Nat.....

1st 24 hrs. after shot.....

Gas.....Cu. Ft.

Dry Hole.....

Abandoned.....

Date

MAR 15 1933

CHAS. L. SHERWOOD

192.....

Scout

log 150

660

E

Map No. 4 **KANSAS** Sec. 26 Twp. 31 R. 10

Well No. 1 Hull

Center State Oil Co. Company

Contractor

COMPLETED

SECTION PLAT

			o

330 Ft. from N. Line

..... Ft. from S. Line

660 Ft. from E. Line

..... Ft. from W. Line

ABANDONED

Location.....

Rig up.....

Drilling and Remarks:

Obwego Line
1665-92

RECORD

Cased 1845 in., ft.

Sand 1845-92

Gas Shew Oil & 2 Bm

Oil.....

Total Depth 1710

PRODUCTION

1st 24 hrs. Nat.....

1st 24 hrs. after shot.....

Gas..... Cu. Ft.

Dry Hole

Abandoned

Date

MAY 24 1933 192

CHAS. L. SHERWOOD

Scout