

Map No. _____ Sec. 35 Twp. 28 R. 5

Well No. #1 Myers Farm _____
Morgan & Sweet Company _____

NORTH

_____ Ft. from N. Line


1120 Ft. from S. Line

_____ Ft. from E. Line

1120 Ft. from W. Line

WEST

EAST

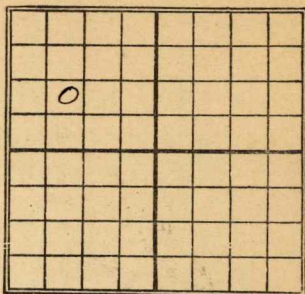

SOUTH

Date

REPORT

1924

7/15

Spudding

10/21

abandoned 2805'

Map No. Kas 11 35 Sec. 28 Twp. 28 R. 5

Well No. 1 Myers

Morgan Sweat Company

Contractor

FIRST REPO

----- Ft. from N. Line

1120 Ft. from S. Line

----- Ft. from E. Line

1120 Ft. from W. Line

SECTION PLAT

o			

Location -----

Rig up -----

Drilling and Remarks:

Spudding

RECORD

Cased ----- in., ----- ft.

Sand -----

Gas -----

Oil -----

Total Depth -----

PRODUCTION

1st 24 hrs. Nat. -----

1st 24 hrs. after shot -----

Gas ----- Cu. Ft.

Dry Hole -----

Abandoned -----

Date

JUL 15 1922

M. A. BENEAR

191

Scout

Map No. *Kans 35* Sec. *28* Twp. *5* R. *5*

Well No. *1 Mupers*

Margant & Sweet Company

Contractor

ABANDONED

SECTION PLAT

----- Ft. from N. Line

1120

----- Ft. from S. Line

----- Ft. from E. Line

1120

----- Ft. from W. Line

0			

Location -----

Rig up -----

Drilling and Remarks:

No show

RECORD

Cased ----- in., ----- ft.

Sand -----

Gas -----

Oil -----

Total Depth -----

PRODUCTION

1st 24 hrs. Nat. -----

1st 24 hrs. after shot -----

Gas ----- Cu. Ft.

Dry Hole -----

Abandoned *2805*

Date

OCT 21 1929 191

M.B. Scout

~~map shows H 3 Shaler-
 Nath Refg. 980 from S +
 1120 from west in SW NW.
 Is this correct.~~

SECTION PLAT

ft. from N. Line
 ft. from E. Line
 ft. from E. Line
 ft. from W. Line

RECORD

Gasch in ft.
 Sand
 Gas
 Oil
 Total Depth

Location
 Rig up
 Drilling and Remarks

PRODUCTION

hrs. after shot
 On ft.
 Gals. per day

Returned
 Cards
 Tracing
 J. S. C. map
 Frantz map
 Moody map
 Frantz plat

Date