


Map No. KANSAS Sec. 26 Twp. 31 R. 10^W
 Well No. 1 - Key Farm
Raff & Frazier Company

NORTH

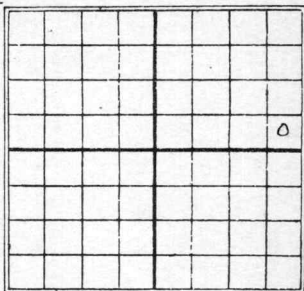

_____ Ft. from N. Line
250 Ft. from S. Line
250 Ft. from E. Line
 _____ Ft. from W. Line

SOUTH

1930

Date	REPORT
5/28	Machine
6/4	Rigged up & S.D.
6/11	
6/18	
6/25	Rign up.
7/2	
7/9	
7/16	
7/23	Spdg. 220'
7/30	10" 735'
8/6	S.D. 750'
8/13	
8/20	Drly 1100'
8/27	" 1500'
9/3	Land 1540-85 Shot 120 qts, & bbl show. hOrly. 1775'
9/10	set 6"-1972' (over)

9/17- Sand 1540-85
Top line 1972
T.O. 1989 show gas
PB. to 1585
shot 120 qt 1540-85
20 bbl oil
Comp.

4 ^{4th} Map No. KANSAS Sec. 26 Twp. 31 R. 10^E

Well No. 1 Key

Craft & Inrazier Company

Contractor

FIRST REPORTS

_____ Ft. from N. Line

750 Ft. from S. Line

750 Ft. from E. Line

_____ Ft. from W. Line

SECTION PLAT

			o

Location _____

Rig up _____

Drilling and Remarks:

Machine.

RECORD

Cased _____ in., _____ ft.

Sand _____

Gas _____

Oil _____

Total Depth _____

PRODUCTION

1st 24 hrs. Nat. _____

1st 24 hrs. after shot _____

Gas _____ Cu. Ft.

Dry Hole _____

Abandoned _____

Date

MAY 28 1930

19

CHAS. L. SHERWOOD
Scout

