


Section.....25- Township.....31 Range.....10-E

Well Number.....1 - Miller

Company.....Diller O&G.

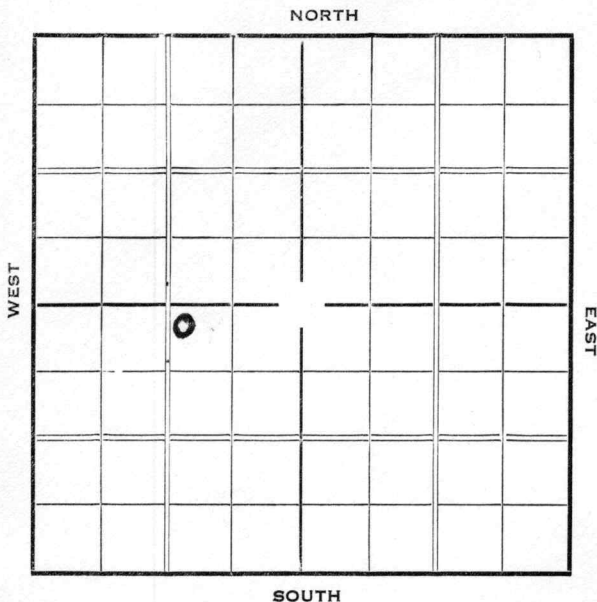

Sec. 25 Twp. 31- R. 10-E


Well No. #1 Miller Farm
Diller O & G Company

250 Ft. from N. Line

_____ Ft. from S. Line

1070 Ft. from E. Line

_____ Ft. from W. Line

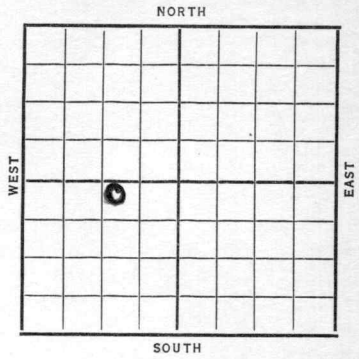

Date	REPORT
1937	
5/19	Location
5/28	"
6/4	Drlg. 475'.
6/11	12" @ 472'. 10" @ 725'. 8" @ 1365'. Drlg. 1625'.
6/19	6" @ 2002'. Sil. 2289'. Drlg. 2290'.
6/23	Sil. 2289'.
	T.D. 2302'. H.F.W.
	ABANDONED

Elk KANSAS

Map No. 4 Sec. 25 Twp. 31 R. 10^E

Well No. 1-Miller

Diller O & S Company

Contractor

FIRST REPORT

SECTION PLAT

250 Ft. from N. Line
_____ Ft. from S. Line
1070 Ft. from E. Line
_____ Ft. from W. Line

	0		

Location ✓

Rig up _____

Drilling and Remarks:

RECORD

Cased _____ in., _____ ft.
Sand _____
Gas _____
Oil _____
Total Depth _____

PRODUCTION

1st 24 hrs. Nat. _____
1st 24 hrs. after shot _____
Gas _____ Cu. Ft.
Dry Hole _____
Abandoned _____

Date

MAY 19 1937

19

H. D. Hatfield Scout

Elk

KANSAS

Map No. 4 Sec. 25 Twp. 31 R. 10

Well No. 1 - Miller

Miller O & G Company

Contractor

SECTION PLAT

ABANDONED

250 Ft. from N. Line

_____ Ft. from S. Line

1070 Ft. from E. Line

_____ Ft. from W. Line

	0		

Location _____

Rig up _____

Drilling and Remarks:

HFW

DVA

RECORD

Cased _____ in., _____ ft.

Sand sil 2289

Gas _____

Oil _____

Total Depth 2302

PRODUCTION

1st 24 hrs. Nat. _____

1st 24 hrs. after shot _____

Gas _____ Cu. Ft.

Dry Hole _____

Abandoned _____

Date

JUN 23 1937 19

H. D. Hatfield Scout