


Kansas

Map No. _____ Sec. 35 Twp. 28 R. 5

Well No. 2 Meyers Farm

Reynolds & Ward Company

NORTH

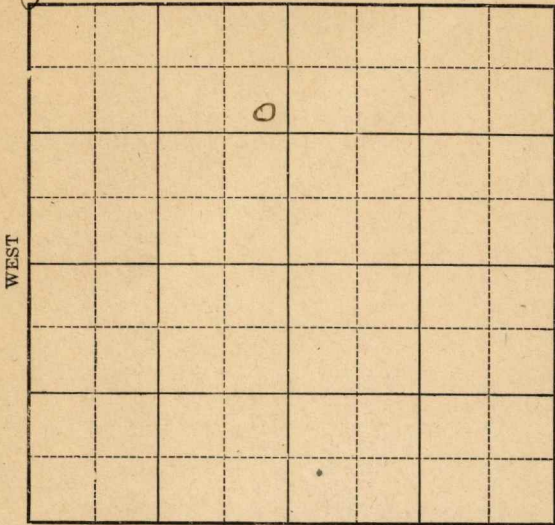

SOUTH

FIRST REPORT

Location _____

Rig Up _____

Drilling Remarks: _____

Drilling Remarks: _____

RECORD

Cased _____ in. _____ ft.

Sand _____

Gas _____

Oil _____

Total Depth _____

PRODUCTION

1st 24 hrs. Nat. _____

1st 24 hrs. after shot _____

Gas _____ cu. ft.

Dry Hole _____

Abandoned _____

Map No. **KANSAS 11** Sec. **35** Twp. **28** R. **5**

Well No. **2 Meyers**

Reynolds & Ward Company
Contractor

FIRST REPORT

SECTION PLAT

1120 Ft. from N. Line

_____ Ft. from S. Line

200 Ft. from E. Line

_____ Ft. from W. Line

	o		

Location _____

Rig up _____

Drilling and Remarks:

Rig & tools

RECORD

Cased _____ in., _____ ft.

Sand _____

Gas _____

Oil _____

Total Depth _____

PRODUCTION

1st 24 hrs. Nat. _____

1st 24 hrs. after shot _____

Gas _____ Cu. Ft.

Dry Hole _____

Abandoned _____

Date

NOV 11 1922

M. A. BENEAR

191

Scout

Map No. **KANSAS** 11 Sec. **35** Twp. **28** R. **5**

Well No. **2 Meyers**
Reynolds & Ward Company

Contractor

COMPLETED SECTION PLAT

1120 Ft. from N. Line

----- Ft. from S. Line

200 Ft. from E. Line

----- Ft. from W. Line

	0		
		1	

RECORD

Location -----

Rig up -----

Drilling and Remarks:

shallow

Cased ----- in., ----- ft.

Sand -----

Gas -----

Oil **2780-93**

Total Depth **2793**

PRODUCTION

1st 24 hrs. Nat. -----

1st 24 hrs. after shot **40**

Gas ----- Cu. Ft.

Dry Hole -----

Abandoned -----

Date **JAN 6 1923**

M. A. BENEAR

----- **191** ----- Scout