


Map No. _____ Sec. 35 Twp. 28 R. 5

Well No. 4 Shawler Farm _____

_____ Company _____

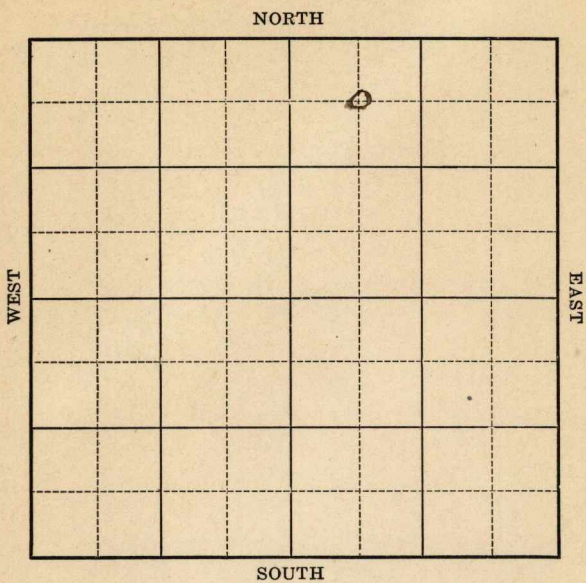

Location _____

Drilling Remarks:

RECORD

Cased _____ in. _____ ft.

Sand _____

Gas _____

Oil _____

Total Depth _____

Rig Up _____

Drilling Remarks:

PRODUCTION

1st 24 hrs. Nat. _____

1st 24 hrs. after shot _____

Gas _____ cu. ft.

Dry Hole _____

Abandoned _____

Map No. K11 Sec. 35 Twp. 28 R. 5

Well No. 4 shawler
S + S. Company _____

Contractor _____

FIRST REPORT

SECTION PLAT

660 Ft. from N. Line
 _____ Ft. from S. Line
 _____ Ft. from E. Line
660 Ft. from W. Line

		o	

Location _____

Rig up _____

Drilling and Remarks:

W. 2500'

RECORD

Cased _____ in., _____ ft

Sand _____

Gas _____

Oil _____

Total Depth _____

PRODUCTION

1st 24 hrs. Nat. _____

1st 24 hrs. after shot _____

Gas _____ Cu. Ft

Dry Hole _____

Abandoned _____

Date

MAY 6 1922

M. A. BENEAR

_____ 191 _____ Scout

Map No. 11 Kans Sec. 35 Twp. 28 R. 5

Well No. #4 Shewler
S. S.

Company

Contractor

ABANDONED

SECTION PLAT

660 Ft. from N. Line

_____ Ft. from S. Line

_____ Ft. from E. Line

660 Ft. from W. Line

		0	

Location _____

Rig up _____

Drilling and Remarks:

Void.

RECORD

Cased _____ in., _____ ft.

Sand _____

Gas _____

Oil _____

Total Depth _____

PRODUCTION

1st 24 hrs. Nat. _____

1st 24 hrs. after shot _____

Gas _____ Cu. Ft.

Dry Hole _____

Abandoned _____

Date

M.A.B.

7/23/24