


Map No. 15 Sec. 26 Twp. 31 R. 10

Well No. 1-walker Farm
Theta Oil Company

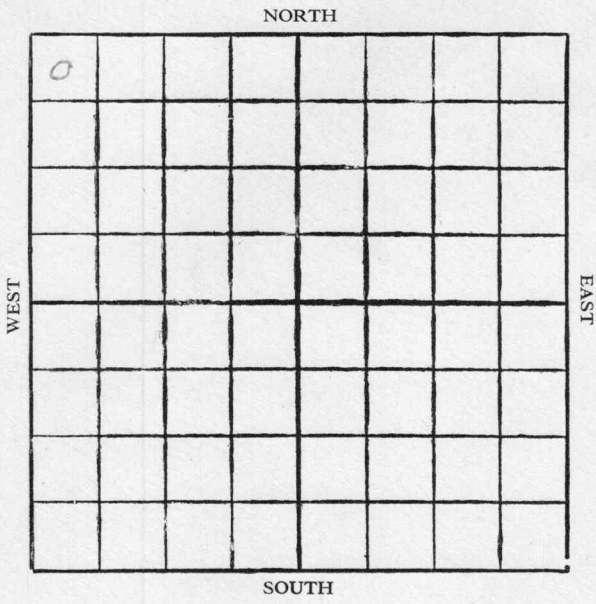

Location

Drilling Remarks

.....

.....

Rig Up.....

Drilling Remarks

.....

.....

RECORD

Cased in. ft.

Sand

Gas

Oil

Total Depth

PRODUCTION

1st 24 hrs. Nat.

1st 24 hrs. after shot

Gas cu. ft.

Dry Hole

Abandoned

Map No. 4 **KANSAS** Sec. 26 Twp. 31 R. 10

Well No. 1 Walker

Shety and Co Company

Contractor

FIRST REPORTS

SECTION PLAT

330 Ft. from N. Line

----- Ft. from S. Line

----- Ft. from E. Line

330 Ft. from W. Line

o			

COMPLETED

Location -----

Rig up -----

Drilling and Remarks:

75 Bl.

had 75 Bl well
grom 1348-60
was shot 79

RECORD

Cased 1630 in., 1639 ft.

Sand 1630-1639

Gas -----

Oil -----

Total Depth 1639

PRODUCTION

1st 24 hrs. Nat. -----

1st 24 hrs. after shot -----

Gas ----- Cu. Ft.

Dry Hole -----

Abandoned -----

Date JAN 8 1927

CHAS. L. SHERWOOD

----- 192 ----- Scout