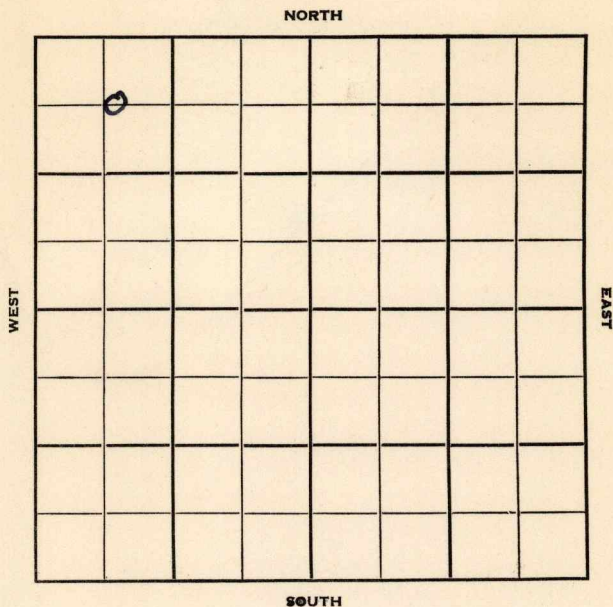


Section 36 Township 28 Range 5 EWell No. # 1 BrownCompany White & Ellis

Butler

KANSAS

Sec. 36 Twp. 28 R. 5E

Well No. #1 Brown Farm

White & Ellis Company

Contractor

660

Ft. from N. Line


Ft. from S. Line

Ft. from E. Line

710

Ft. from W. Line

50' E of C NW NW

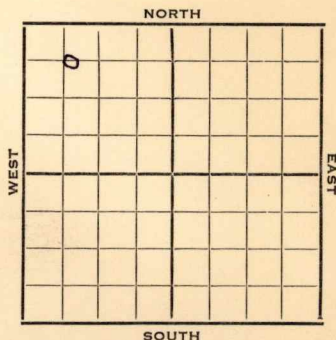

1952

Elev. 1342' REPORT


5/28

Spud 5-25-52
Set Surf.

7/16

Spud 5-25-52
Oil Well TD 2803
Bart 2788 TD 2803
5" @ 2781 DP to 2803
24/2780-86 in Bart
Hydro Comp. 25 bopd

COMPLETED

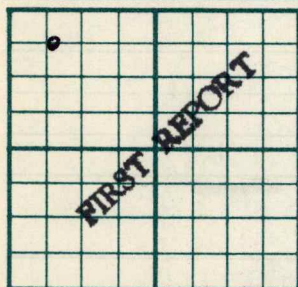County **Butler** State **Kansas**Sec. **36** (Blk. Twp.) **28** (Sur. Rge.) **5E** Map No.Operator **White & Ellis**Well No. **1** Farm **Brown**Elev. Location **50' E of C NW NW****660** Ft. From **N** Line **NW****710** Ft. From **W** Line Quarter1st. Report **MAY 28 1952**

Completion

Remarks

Spudding Date **5-25-52**

Drlg. Data

Set Surf**J. G. McGEHEE**

County Butler State Kansas
 Sec. 36 (Blk. 28 (Sur. 5E Map No.)
 (Twp.) (Rge.)

Operator White & Ellis

Well No. 1 Farm Brown

Elev. 1342 Location C NW NW

660 Ft. From N Line NW

710 Ft. From W Line Quarter

1st. Report

Completion Jul 1 6 1952

Remarks

Spudding Date 5-25-52

Drlg. Data Oil well TD 2803

Bart. 2788 TD 2803 5" @ 2781

DP to 2803 24/ 2780-86 in Bart.

Hydro. Comp. 25 bopd

J. G. McGENEE