


Section 36 Township 28 Range 5E

Well No. #2 Brown

Company Morrison

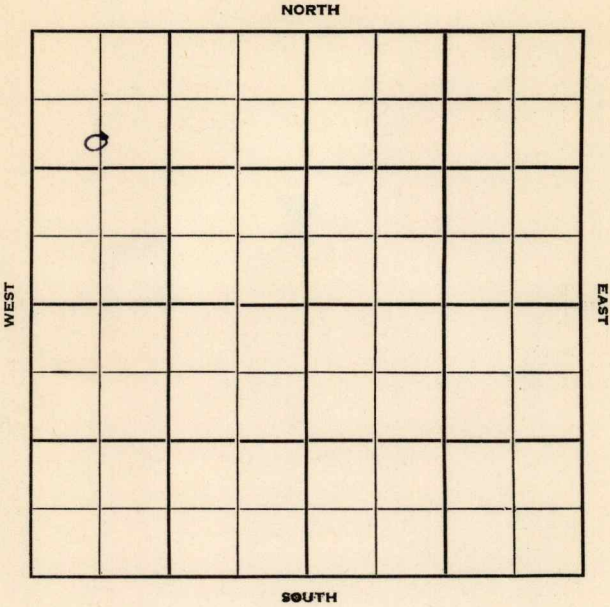

Sec. 36 Twp. 28 R. 5E

Well No. #2 Brown Farm

Morrison Company

Morrison Contractor


1212 Ft. from N. Line

_____ Ft. from S. Line

_____ Ft. from E. Line

635 Ft. from W. Line

App. C S/2 NW NW

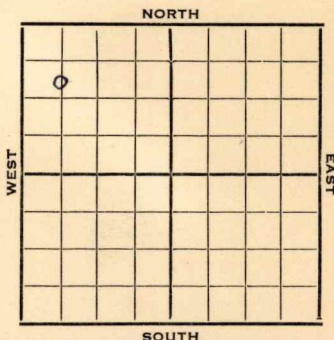


1952 **Elev. 1340'** REPORT

8/20 8" @ 90'
Drlg. 1690'

9/17 Oil well TD 2795' 8" @ 90
Bart 2777 TD 2795 5" @ 2779
DP to 2795 Hydro.
Comp. 25 BOPD

COMPLETED

County **Butler** State **Kansas**
 Sec. **36** (Blk.) **28** (Sur.) **5E** Map No.
 Operator **Morrison**
 Well No. **2** Farm **Brown**
 Elev. Location **App C S/2 NW NW**

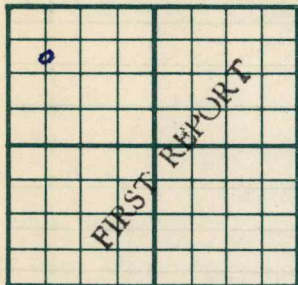

1212 Ft. From **N** Line **NW**
635 Ft. From **W** Line Quarter

1st. Report **AUG 20 1952**

Completion

Remarks

Morrison - Contr.

Spudding Date

Drlg. Data

8" @ 90 Drlg. 1690

J. G. McGEHEE

County Butler State Kansas
 Sec. 36 (Blk. 28 (Sur. 5E Map No.)
 (Twp.) (Rge.)

Operator Morrison Drlg.

Well No. 2 Farm Brown

Elev. 1340 Location C S L NW NW

COMPLETE

1212Ft. From N Line NW

635Ft. From W Line Quarter

1st. Report

Completion SEP 17 1952

Remarks

Morrison Drlg. - Contr.

Spudding Date

Drlg. Data Oil well TD 2795

8" @ 90 Bart. 2777 TD 2795 5" @ 2779

DP to 2795 Hydro. Comp. 25 bopd