


Map No. Ks Sec. 27 Twp. 31 R. 10

Well No. 1 - Murphy Farm
Theta oil Company

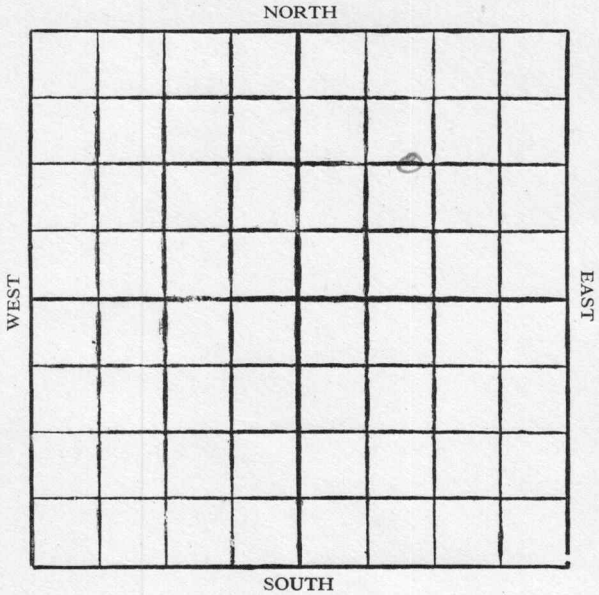

Location

Drilling Remarks

.....

.....

RECORD

Cased in. ft.

Sand

Gas

Oil

Total Depth

Rig Up.....

Drilling Remarks

.....

.....

PRODUCTION

1st 24 hrs. Nat.

1st 24 hrs. after shot.....

Gas cu. ft.

Dry Hole

Abandoned

ELK

Map No. Kansas Sec. 27 Twp. 31 R. 10^E


Well No. 1 murphy Farm
Theta Oil Company

1320 Ft. from N. Line

_____ Ft. from S. Line

_____ Ft. from E. Line

1070 Ft. from W. Line

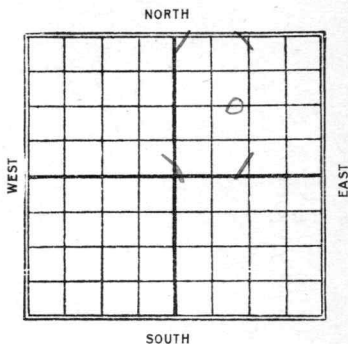

Date

1927

REPORT

1/8 Sand 2291-2298
 T.D. 2304 Top line 2000
 H.F.W. 2294 Show 1645-1670
 Abandoned 2304

4 KANSAS
 Map No. _____ Sec. 27 Twp. 31 R. 10^W
 Well No. 1 Murphy
 Shets od @ _____ Company

_____ Contractor

FIRST REPORTS

SECTION PLAT

1320 Ft. from N. Line
 _____ Ft. from S. Line
 _____ Ft. from E. Line
 1070 Ft. from W. Line



COMPLETED

Location _____
 Rig up _____
 Drilling and Remarks:

RECORD
 Cased _____ in., _____ ft.
 Sand 2291-2298
 Gas _____
 Oil _____
 Total Depth 2304

TL 2000
 AFW 2294
 Shets od 1645-1670

PRODUCTION
 1st 24 hrs. Nat. _____
 1st 24 hrs. after shot _____
 Gas _____ Cu. Ft.
 Dry Hole
 Abandoned _____

Date
 JAN 8 1927

CHAS. L. SHERWOOD