


Map No. KANSAS Sec. 27 Twp. 31 R. 10
 Well No. 1-Murphy Farm
Wahn et al Company

400 Ft. from N. Line

..... Ft. from S. Line

..... Ft. from E. Line

1120 Ft. from W. Line

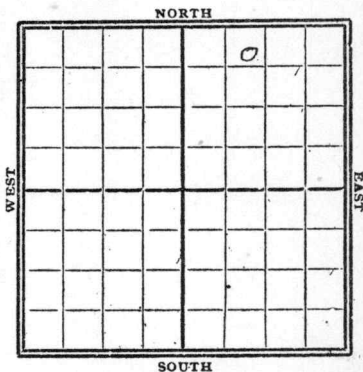

1928

Date REPORT

Date	REPORT
11/7	D. Only 600'
11/14	" 900'
11/21	" 1317'
11/28	" 1380'
12/5	" 1600'
12/12	S.D. 1600'
12/19	—
12/26	—
1929	
1/2	—
1/9	—
1/16	—
1/23	—
1/30	Top Oswego 1596' T.D. 1710'
	Dry & Abandoned

Elk

K4 KANSAS MAP NO. _____ SEC. 27 TWP. 31 R. 10

WELL NO. 1 *Murphy*
Wahn et al COMPANY

CONTRACTOR

FIRST REPORTS

SECTION PLAT

400 FT. FROM N. LINE
 _____ FT. FROM S. LINE
 _____ FT. FROM E. LINE
1120 FT. FROM W. LINE

		0	

LOCATION _____

RIG UP _____

DRILLING AND REMARKS:

Dg 600'

RECORD

CASED _____ IN., _____ FT.
 SAND _____
 GAS _____
 OIL _____
 TOTAL DEPTH _____

PRODUCTION

1ST 24 HRS. NAT. _____
 1ST 24 HRS. AFTER SHOT _____
 GAS _____ CU. FT.
 DRY HOLE _____
 ABANDONED _____

DATE

NOV 7 1928

CHAS. L. SHERWOOD
 192 SCOUT

Map No. **KANSAS** Sec. *27* Twp. *31* R. *10*
 Well No. *44 1* *Murphy*
Wahn & al Company

Contractor

COMPLETE

SECTION PLAT

400 Ft. from N. Line
 Ft. from S. Line
 Ft. from E. Line
1120 Ft. from W. Line

		0	

ABANDONED

Location.....
 Rig up.....

Drilling and Remarks:
Top Oswego 1596

RECORD

Cased.....in.,ft.
 Sand.....
 Gas.....
 Oil.....
 Total Depth.....*1710*

PRODUCTION

1st 24 hrs. Nat.....
 1st 24 hrs. after shot.....
 Gas.....Cu. Ft.
 Dry Hole
 Abandoned

Date

JAN 30 1929

192 **CHAS. L. SHERWOOD** Scout