

Well No. 3 Brown Farm

Well No. 3 Brown Farm Derby Oil Company

WEST

EAST

SOUTH

FIRST REPORT

Rig Up **COMPTON**

Drilling Remarks:

PRODUCTION

1st 24 hrs. Nat.

1st 24 hrs. after shot

Gas _____ cu. ft.

Dry Hole _____

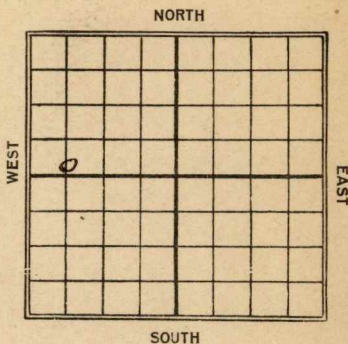
Abandoned _____

Map No. Kans. Sec. 36 Twp. 28 R. 5Well No. 3 Brown Farm
Derby Oil Company

Ft. from N. Line

200 Ft. from S. Line

Ft. from E. Line

660 Ft. from W. Line

Date

REPORT

1922

8/28

Rig.

11/11

Sand 2742-76 - Shot
40 gts - 75 Bblo.

Map No. Kans 11 Sec. 36 Twp. 28 R. 5

 Well No. 3 Brown
Herby oil Company

Contractor

FIRST REPORT

SECTION PLAT

o			

Ft. from N. Line

200 Ft. from S. Line

Ft. from E. Line

660 Ft. from W. Line

Location

Rig up

Drilling and Remarks:

RECORD

Cased _____ in., _____ ft.

Sand _____

Gas _____

Oil _____

Total Depth _____

PRODUCTION

1st 24 hrs. Nat. _____

1st 24 hrs. after shot _____

Gas _____ Cu. Ft.

Dry Hole _____

Abandoned _____

Date

AUG 28 1922

M. A. BENEAR

191

Scout

Map No. **KANSAS** ^H Sec. **36** Twp. **28** R. **5**Well No. **3 Brown****Derby oil** Company

Contractor

COMPLETED SECTION PLAT

Ft. from N. Line

200 Ft. from S. Line

Ft. from E. Line

1060 Ft. from W. Line

Location

Rig up

Drilling and Remarks:

shot 40 ft**RECORD**

Cased _____ in., _____ ft.

Sand _____

Gas _____

Oil **2742 - 76**Total Depth **2776****PRODUCTION**

1st 24 hrs. Nat. _____

1st 24 hrs. after shot **75**

Gas _____ Cu. Ft.

Dry Hole _____

Abandoned _____

Date

NOV 11 1922**M. A. BENEAR**

191

Scout