Form 51-10M-7-20-CroMac

Map No. A Sec. 36 Twp. 28 R. 5

Well No. 3 Brown Farm


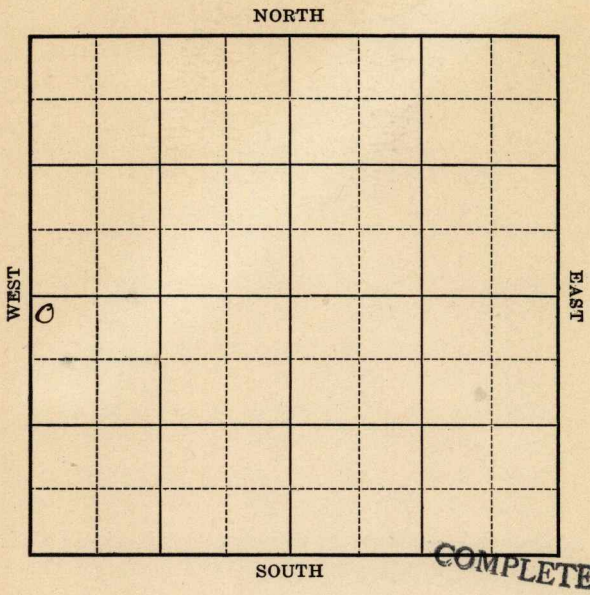

Location _____

Drilling Remarks:

Rig Up _____

Drilling Remarks:

RECORD

Cased _____ in. _____ ft.

Sand _____

Gas _____

Oil _____

Total Depth _____

PRODUCTION

1st 24 hrs. Nat. _____

1st 24 hrs. after shot _____

Gas _____ cu. ft.

Dry Hole _____

Abandoned _____

Form 252A 8M-11-20 PALACE-TULSA 4617

Map No. K Sec. 36 Twp. 28 R. 5

Well No. 3 Brown Farm

Kansas & Gulf. Company

200 Ft. from N. Line

Ft. from S. Line

Ft. from E. Line

200 Ft. from W. Line

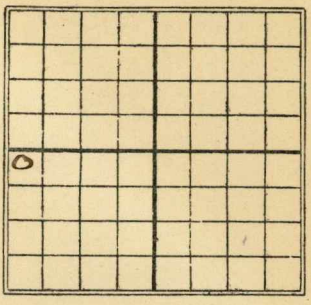

Date 1922	REPORT COMPLETED
1/3	Wly @ 1000'
1/21	2746-2793 - Shot 20 qts - flowing 120 bbls

Form 148—7-20—500 Bks—CroMac

Map No. 11 Sec. 36 Twp. 28 R. 5

Well No. 3 Brown Farm

Kansas & Gulf Company

Date Started _____ Ft. from N. ___ S. ___ E. ___ W. 200 line

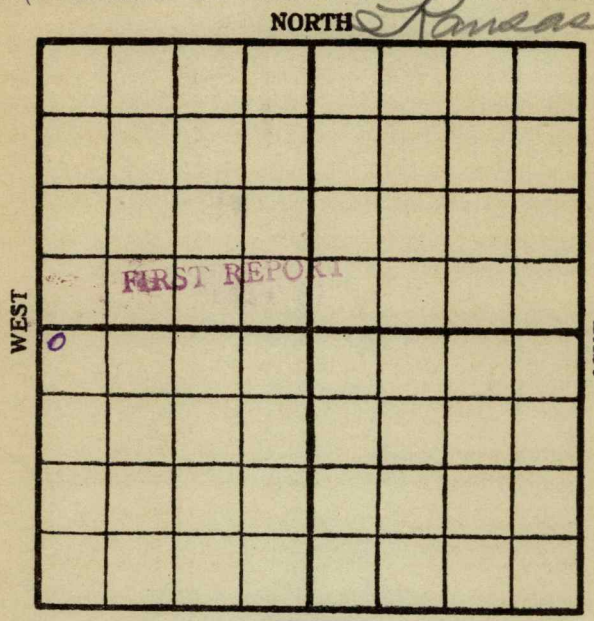

Cased _____ In. _____ Ft.

Sand _____

Pay { Gas _____ / Oil _____

Total Depth _____

Production Remarks

Condition of Well on this date _____

20 lg. at 1006'

M. A. BENEAR

_____ Scout

Form 26—1M—4-19—Mid-West

Map No. K11 Sec. 31 Twp. 27 R. 5

Well No. #3 Brown

Kansas Gulf Company

Contractor

COMPLETED

SECTION PLAT

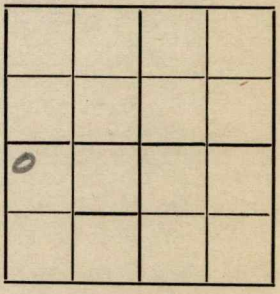

200 Ft. from N. Line

Ft. from S. Line

Ft. from E. Line

200 Ft. from W. Line

Location

Rig up

Drilling and Remarks:

sand 2746
2793.
shot 20qts
flowing
1207 lbs.

RECORD

Cased in., ft.

Sand

Gas

Oil

Total Depth

PRODUCTION

1st 24 hrs. Nat.

1st 24 hrs. after shot

Gas Cu. Ft.

Dry Hole

Abandoned

Date

JAN 27 1922 191

M. A. BENEAR Scout