


Map No. 15 Sec. 26 Twp. 31 R. 10
Well No. 3-walker Farm
Theta oil co. Company

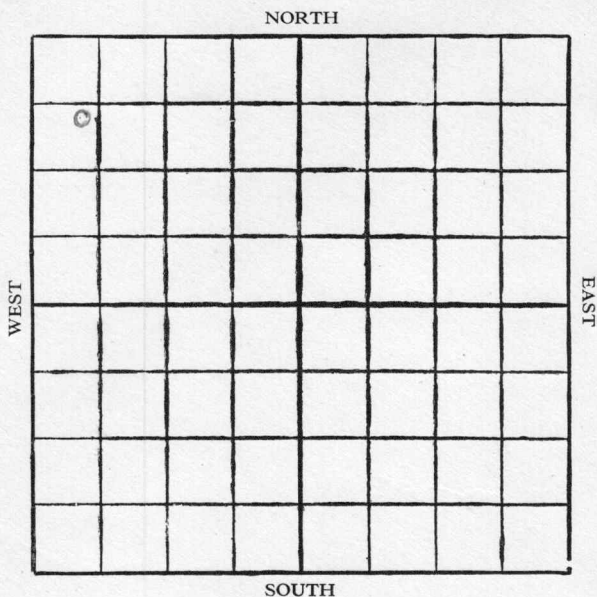

Location
Drilling Remarks

Rig Up.....
Drilling Remarks

RECORD

Cased..... in. ft.
Sand
Gas
Oil
Total Depth.....

PRODUCTION

1st 24 hrs. Nat.....
1st 24 hrs. after shot.....
Gas..... cu. ft.
Dry Hole.....
Abandoned.....

ELK

Map No. Kansas Sec. 26 Twp. 31 R. 10


Well No. 3 Walker Farm
Theta Oil Company

810 Ft. from N. Line

_____ Ft. from S. Line

_____ Ft. from E. Line

510 Ft. from W. Line

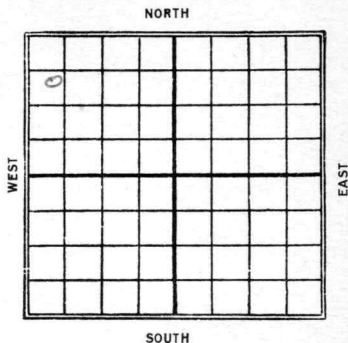

Date

REPORT

1927

1/8 Drilling 225
2/24 sand 1652-1661
15 bbls
38 gravity

4 KANSAS 26 31 10
 Map No. Sec. Twp. R.
 Well No. 3 Walker
 Shotg O & Co Company

Contractor

FIRST REPORTS

810 Ft. from N. Line

Ft. from S. Line

Ft. from E. Line

510 Ft. from W. Line

SECTION PLAT

Location

Rig up

Drilling and Remarks:

Dtg 225'

RECORD

Cased in., ft.

Sand

Gas

Oil

Total Depth

PRODUCTION

1st 24 hrs. Nat.

1st 24 hrs. after shot

Gas Cu. Ft.

Dry Hole

Abandoned

Date

JAN 8 1927

192

CHAS. L. SHERWOOD

Scout

4 KANSAS *Elk*
 Map No. _____ Sec. *26* Twp. *31* R. *10*
 Well No. *3 Walker*
Thetys Oil Co Company

Contractor

COMPLETED

SECTION PLAT

810 Ft. from N. Line

_____ Ft. from S. Line

_____ Ft. from E. Line

510 Ft. from W. Line

<i>0</i>			

Location _____

Rig up _____

Drilling and Remarks:

15 Bls.

38 Gravity

RECORD

Cased _____ in., _____ ft.

Sand *1652-1661*

Gas _____

Oil _____

Total Depth *1661*

PRODUCTION

1st 24 hrs. Nat. _____

1st 24 hrs. after shot _____

Gas _____ Cu. Ft.

Dry Hole _____

Abandoned _____

Date

FEB 25 1927

CHAS. L. SHERWOOD

192

Scout