

WEST

EAST

SOUTH

FIRST REPORT

Rig Up_____

Drilling Remarks:

PRODUCTION

1st 24 hrs. Nat. _____

1st 24 hrs. after shot

Gas _____ cu. ft.

Dry Hole _____

Abandoned _____

Map No. _____ Sec. 36 Twp. 28 R. 5Well No. # 4 Brown Farm _____
Kansas & Gulf Company

NORTH


_____ Ft. from N. Line

200 Ft. from S. Line

_____ Ft. from E. Line

660 Ft. from W. Line

WEST

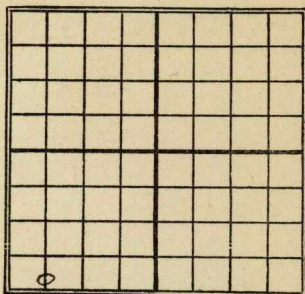

SOUTH

Date

REPORT

19223/30Spudding5/21299 2849

Kansas

Map No. K11 Sec. 36 Twp. 28 R. 5Well No. 4 BrownKansas & Gulf Company

Contractor

FIRST REPORT

SECTION PLAT

Ft. from N. Line

300 Ft. from S. Line

Ft. from E. Line

660 Ft. from W. Line

Location

Rig up

Drilling and Remarks:

spudding

RECORD

Cased _____ in., _____ ft.

Sand _____

Gas _____

Oil _____

Total Depth _____

PRODUCTION

1st 24 hrs. Nat. _____

1st 24 hrs. after shot _____

Gas _____ Cu. Ft.

Dry Hole _____

Abandoned _____

Date

MAR 30 1922

191

M. A. BENEAR

Scout

11
 Map No. Kans Sec. 36 Twp. 28 R. 5

 Well No. 4 Brown
Kansas & Gulf Company

Contractor

ABANDONED
SECTION PLAT

Ft. from N. Line

200 Ft. from S. Line

Ft. from E. Line

660 Ft. from W. Line

Location

Rig up

Drilling and Remarks:

L0+A 2849
RECORD

Cased in., ft.

Sand

Gas

Oil

Total Depth

PRODUCTION

1st 24 hrs. Nat.

1st 24 hrs. after shot

Gas Cu. Ft.

Dry Hole

Abandoned

Date

MAY 21 1922

191

M. A. BENEAR

Scout