


Map No. Kans Sec. 31 Twp. 30 R. 6

Well No. 4 Elliott Farm

Leaves Oil Company

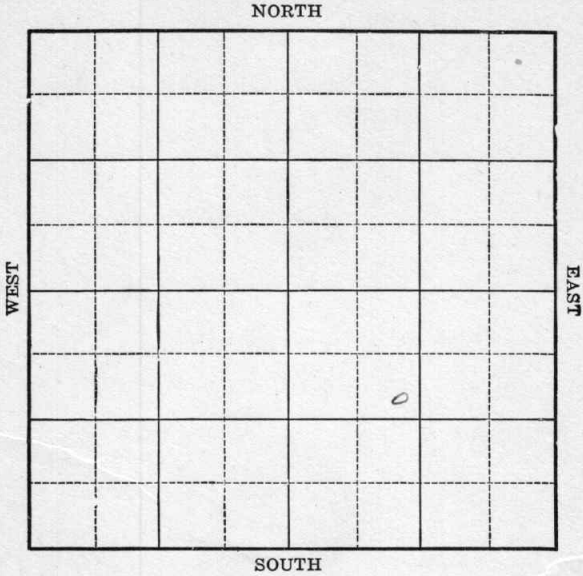

Location \_\_\_\_\_  
Drilling Remarks \_\_\_\_\_  
\_\_\_\_\_  
\_\_\_\_\_  
Rig Up \_\_\_\_\_  
Drilling Remarks \_\_\_\_\_  
\_\_\_\_\_  
\_\_\_\_\_  
RECORD

Cased \_\_\_\_\_ in. \_\_\_\_\_ ft.  
Sand \_\_\_\_\_  
Gas \_\_\_\_\_  
Oil \_\_\_\_\_  
Total Depth \_\_\_\_\_

PRODUCTION


1st 24 hrs. Nat. \_\_\_\_\_  
1st. 24 hrs. after shot \_\_\_\_\_  
Gas \_\_\_\_\_ cu. ft.  
Dry Hole \_\_\_\_\_  
Abandoned \_\_\_\_\_

Cowley

Map No. Kans Sec. 31 Twp. 30 R. 6Well No. 4 Elliott FarmLewis Oil Company990 Ft. from N. Line

Ft. from S. Line

Ft. from E. Line

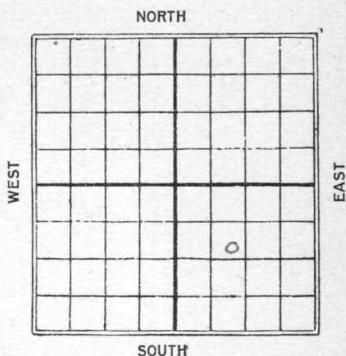1120 Ft. from W. Line

Date

## REPORT

192412/30 Reg up19251/21 Sh 19002/8 Gas 2865-90Oil 2890-290620 gts 90 Bbls

Map No. 11 Sec. 31 Twp. 30 R. 6Well No. 4 E. ElliottLewis Oil Company

Contractor

## FIRST REPORTS

## SECTION PLAT

990 Ft. from N. Line

Ft. from S. Line

Ft. from E. Line

1120 Ft. from W. Line

|  |  |  |  |
|--|--|--|--|
|  |  |  |  |
|  |  |  |  |
|  |  |  |  |
|  |  |  |  |
|  |  |  |  |

Location

Rig up ✓✓

Drilling and Remarks:

## RECORD

Cased \_\_\_\_\_ in., \_\_\_\_\_ ft.

Sand \_\_\_\_\_

Gas \_\_\_\_\_

Oil \_\_\_\_\_

Total Depth \_\_\_\_\_

## PRODUCTION

1st 24 hrs. Nat. \_\_\_\_\_

1st 24 hrs. after shot \_\_\_\_\_

Gas \_\_\_\_\_ Cu. Ft.

Dry Hole \_\_\_\_\_

Abandoned \_\_\_\_\_

Date

12-30 1924 M.A.B. Scout

Map No. 11 **KANSAS** Sec. 31 Twp. 30 R. 6
Well No. 4 E. MattLewis Oil Company

Contractor

**COMPLETED SECTION PLAT**990 Ft. from N. Line

\_\_\_\_\_ Ft. from S. Line

\_\_\_\_\_ Ft. from E. Line

1120 Ft. from W. Line

|  |  |   |  |
|--|--|---|--|
|  |  |   |  |
|  |  |   |  |
|  |  | 0 |  |
|  |  |   |  |

Location \_\_\_\_\_

Rig up \_\_\_\_\_

Drilling and Remarks:

Gas 2865-90Oil 2890-290620/90 bbl**RECORD**

Cased \_\_\_\_\_ in., \_\_\_\_\_ ft.

Sand \_\_\_\_\_

Gas \_\_\_\_\_

Oil \_\_\_\_\_

Total Depth \_\_\_\_\_

**PRODUCTION**

1st 24 hrs. Nat. \_\_\_\_\_

1st 24 hrs. after shot \_\_\_\_\_

Gas \_\_\_\_\_ Cu. Ft.

Dry Hole \_\_\_\_\_

Abandoned \_\_\_\_\_

Date

2/8 1925**M. A. BENEAR**

Scout