


Map No. 45 Sec. 27 Twp. 31 R. 10

Well No. 3-walker Farm  
Theta oil Company

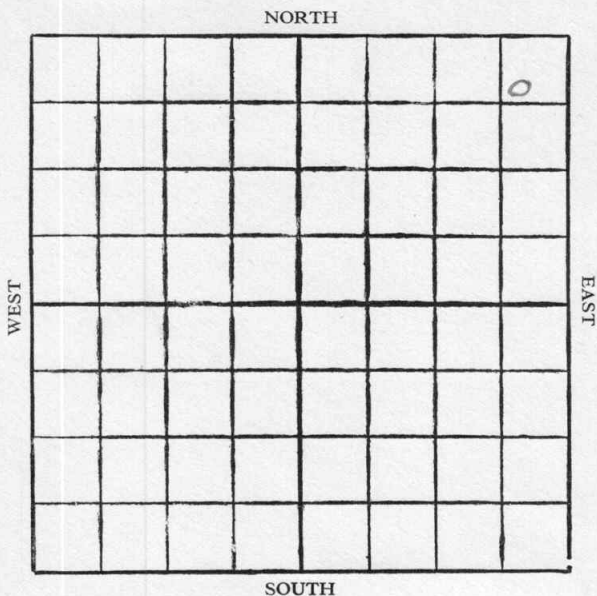

Location .....

Drilling Remarks

Rig Up .....

Drilling Remarks

**RECORD**

Cased ..... in. .... ft.

Sand .....

Gas .....

Oil .....

Total Depth .....

**PRODUCTION**

1st 24 hrs. Nat. ....

1st 24 hrs. after shot .....

Gas ..... cu. ft.

Dry Hole .....

Abandoned .....


ELK

Map No. Kansas Sec. 27 Twp. 31 R. 10

Well No. 3 Walker Farm

Theta Oil Company

NORTH

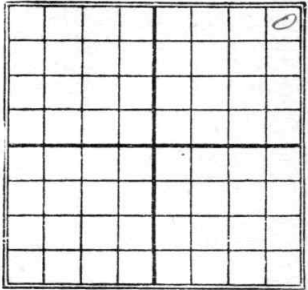

510 Ft. from N. Line

..... Ft. from S. Line

510 Ft. from E. Line

..... Ft. from W. Line

SOUTH

Date

REPORT

1927

1/8

Sand 1200-1221  
1/4 ~~in~~ Gas

2615

4 KANSAS Map No. Sec. 27 Twp. 31 R. 10

Well No. 3 Walker Shets and Co Company

Contractor

FIRST REPORTS

SECTION PLAT

510 Ft. from N. Line

Ft. from S. Line

510 Ft. from E. Line

Ft. from W. Line

COMPLETED

			0

Location

Rig up

Drilling and Remarks:

500 wup for fuel.

RECORD

Cased in, ft.

Sand

Gas 1200-1221

Oil

Total Depth 1221

PRODUCTION

1st 24 hrs. Nat.

1st 24 hrs. after shot

Gas 1/4 M Cu. Ft.

Dry Hole

Abandoned

Date

JAN 8 1927

CHAS. L. SHERWOOD

192

Scout