
KANSAS

FORM 51 5M 4-41 PETROL Rush

Section 36 Township 18 Range 16-W

Well No. 2 Pascoe

Company Schermerhorn

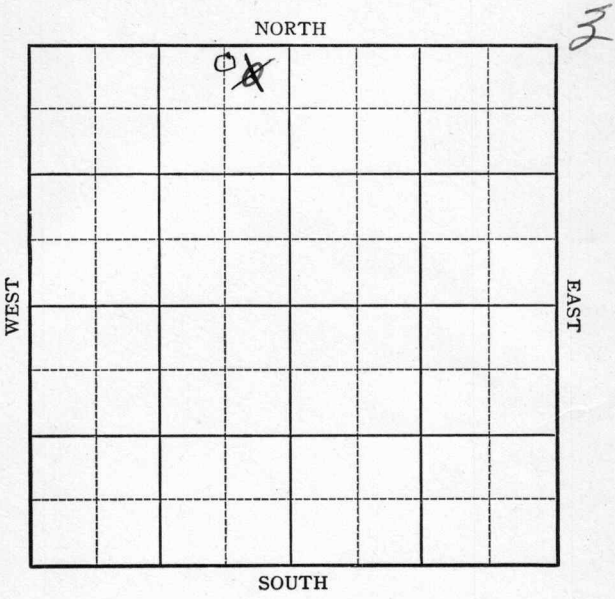

FORM 252-A 5M 6-41 PETROL KANSAS Rush

Sec. 36 Twp. 18 R. 16-W

Well No. #2 Pascoe Farm

Schermerhorn Company


(Otis)

330 Ft. from N. Line

Ft. from S. Line

~~330~~ 660 Ft. from E. Line

Ft. from W. Line

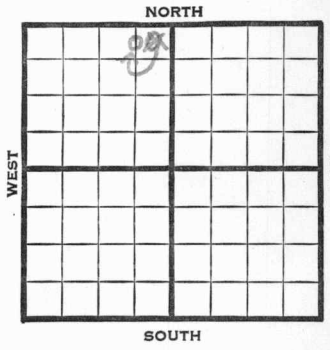

Elev. 1957

1941	REPORT
7/9	Location
7/17	Rotary.
7/24	Anhy 980 TD 985 Run csg.
7/31	10" - 981' Drlg. 2220'
8/8	Lansing 3168? Drlg. 3479'
8/15	Basal sand 3569
	7" - 3569'
	T.D. 3581'
	600' oil in 4 hrs S.D.
	no water.
8/20	Basal sand 3569'
	7" - 3569'
	T.D. 3584'
	Pump 208 oil & 5% water.
	32.5 Gravity
	COMPLETED

Form 26 200 Bks. 5-41 McW. Rush KANSAS

Map No. B4 Sec. 36 Twp. 18 R. 16W

Well No. 2 Pascoe

Schermerhorn Company

Contractor

FIRST REPORT

NE NE NW

330 Ft. from N. Line


Ft. from S. Line

330 Ft. from E. Line

Ft. from W. Line

OTIS GAS POOL

SECTION PLAT

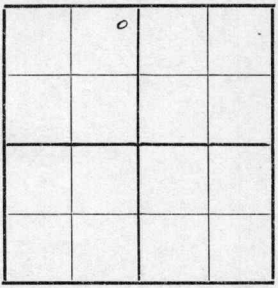

Location X

Rig up

Drilling and Remarks:

RECORD

Cased in., ft.

Sand

Gas

Oil

Total Depth

PRODUCTION

1st 24 hrs. Nat.

1st 24 hrs. after shot

Gas Cu. Ft.

Dry Hole

Abandoned

Date

JUL 9 1941 19 S. J. LEWIS Scout

Form 26 200 Bks. 5-41 McW. Rush KANSAS

Map No. 74 Sec. 36 Twp. 18 R. 16W

Well No. 2 Pascoe

Schermerhorn Company

CORRECTION Contractor

C N L NE NW

330 Ft. from N. Line


Ft. from S. Line

660 Ft. from E. Line

Ft. from W. Line

OTIS GAS POOL

SECTION PLAT

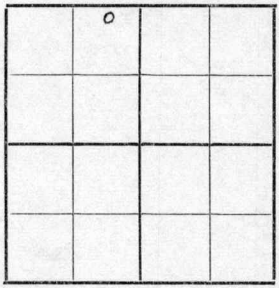

Location

Rig up

Drilling and Remarks:

Reported
NE NW

RECORD

Cased in., ft.

Sand

Gas

Oil

Total Depth

PRODUCTION

1st 24 hrs. Nat.

1st 24 hrs. after shot

Gas Cu. Ft.

Dry Hole

Abandoned

Date

JUL 23 1941 19 S. J. LEWIS Scout

Form 26 200 Bks. 5-41 McW. Rush KANSAS

Map No. 74 Sec. 36 Twp. 18 R. 16W

Well No. 2 Pascoe

Schermerhorn Company

COMPLETED Contractor

C N L NE NW

330 Ft. from N. Line


Ft. from S. Line

660 Ft. from E. Line

Ft. from W. Line

OTIS GAS POOL

SECTION PLAT

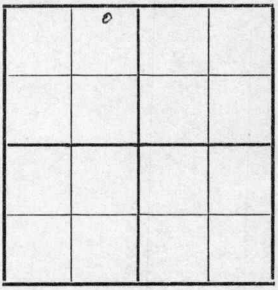

Location

Rig up

Drilling and Remarks:

Basal Sand 3569

7" @ 3569

Pump .208 oil + 5% Water B.S.W.

325 G.

RECORD

Cased in., ft.

Sand

Gas

Oil

Total Depth 3584

PRODUCTION

1st 24 hrs. Nat.

1st 24 hrs. after shot

Gas Cu. Ft.

Dry Hole

Abandoned

Date

AUG 20 1941 19 S. J. LEWIS Scout