

KANSAS

FORM 51 IOM 12-46 PETROL

Rush

Section 36 Township 18 Range 16-W

Well No. #1 Schroeder

Company Eldorado Ref. etal

NORTH

16

							σ

SOUTH

WEST

EAST

O.W.W.O.

KANSAS

Albert Pool

Sec. 36 Twp. 18 R. 16-W

Well No. 1 Schroader Farm

Atlas Drilling
~~Eldorado Ref~~ *et al* Company


SE/C

 Ft. from N. Line

330 Ft. from S. Line

330 Ft. from E. Line

 Ft. from W. Line

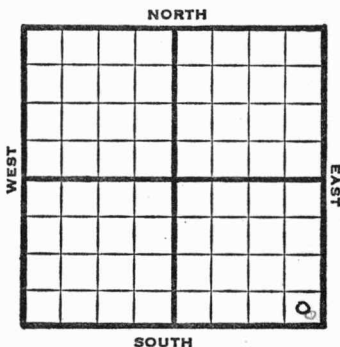

Rush County

1947 2041 REPORT

2-12 Drlg. 665

2/19 Anhy 1078'
8" @ 1074
Drlg 2788'

2/26 Reagan 3673-80
TD 3680
5" @ 3673'
RUST

3/5 TD 3680'
RUST

3/11 TD 3732
HPW

3/26 Reagan 3673'
5" @ 3673'
TD 3734'

ABANDONED

1950 O.W.W.O.

11/1 Cong 3638 Regan 3673

5" @ 3673

OTD 3734 was D&A

CO to 3473 set whipstock @ 3473

Drlg in new hole

OVER

1950

11/1

Regan 3678-85 TD

DST 3679-85 opn 1hr rec 35' ocm

& 150' water

D&A


FIRST REPORT

ABANDONED

Kansas **KANSAS**Map No. 74 Sec. 36 Twp. 18 R. 16WWell No. 1 SchroederEldorado Ref. etal. Company**FIRST REPORT**

Contractor

SE/C

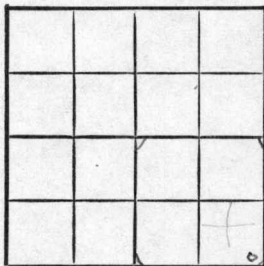SECTION PLAT Ft. from N. Line330 Ft. from S. Line330 Ft. from E. Line Ft. from W. Line

Rush County

Location Rig up

Drilling and Remarks:

drlg. 665

RECORDCased in., ft.Sand Gas Oil Total Depth **PRODUCTION**1st 24 hrs. Nat. 1st 24 hrs. after shot Gas Cu. Ft.Dry Hole Abandoned

Date

FEB 12 1947 19 S. J. LEWIS Scout

Map No. K74 Sec. 36 Twp. 18 R. 16W

Well No. 1 Schroeder

Eldorado Ref. etal.


Company

ABANDONED

Contractor

SE/C

E12041
SECTION PLAT

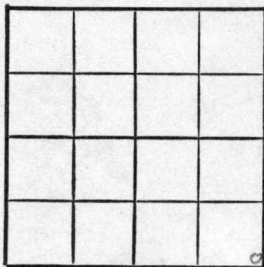

 Ft. from N. Line

330 Ft. from S. Line

330 Ft. from E. Line

 Ft. from W. Line

Rush County

Location

Rig up

Drilling and Remarks:

Reagan 8673
50208673

RECORD

Cased in., ft.

Sand

Gas

Oil

Total Depth 87.34

PRODUCTION

1st 24 hrs. Nat.

1st 24 hrs. after shot

Gas Cu. Ft.

Dry Hole

Abandoned

Date

MAR 26 1947 19

S. J. LEWIS Scout

FIRST REPORT
ABANDONED

330 Ft. From	S	Line	SE
330 Ft. From	E	Line	Quarter
1st. Report	NOV 1	1950	
Completion	NOV 1	1950	
Remarks	OWWO		
Spudding Date			

Drlg. Data

Cong. 3638 Regan 3673 5" @ 3673
OTD 3734 was D&A
CO to 3473 Set Whipstock @ 3473
drilg. in new hole Regan 3678-85 TD
DST 3679-85 open 1 hr. Rec. 35' ocm
& 150' water D & A

J. E. TYRA