KANSAS


Rush

Form 51—5M—7-40—Palace

Section 36 Township 18 Range 16W

Well No. #4 Schroeder

Company Schermerhorn

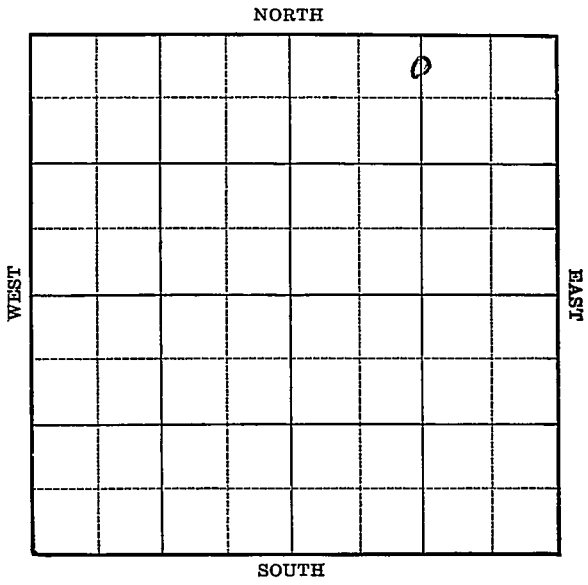

FORM 252-A 5M 7-40 PETROL KANSAS Rush

Sec. 36 Twp. 18 R. 16-W

Well No. #4 Schroeder Farm

Schermerhorn Company


(Albert)

330 Ft. from N. Line

_____ Ft. from S. Line

1320 Ft. from E. Line

_____ Ft. from W. Line

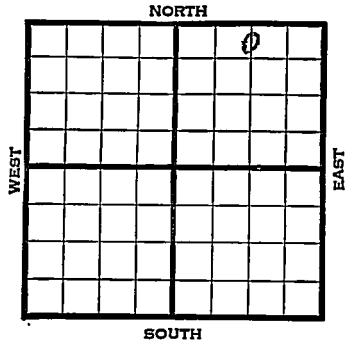

Elev. 1988

1940	REPORT
10/16	16" - 250' Anhy. 998'
	Ream Hole 1013'
10/24	" " "
10/31	Reagan ~~3586-88~~ 3571' T.D. Run csg.
11/7	Reagan 3591' (Corrected)
	7" - 3588' T.D. 3601'
	2400' oil 6 hours.
11/13	Reagan 3591'
	7" - 3588'
	T.D. 3601'
	Depthograph potential 1400 bbls.
	COMPLETED

Form 26—200 Bks.—1-40—Palace Rush KANSAS

Map No. 74 Sec. 36 Twp. 18 R. 16W

Well No. 4 Schroeder

Schermmerhorn Company

Contractor

FIRST REPORT

C N L NE

330 Ft. from N. Line


Ft. from S. Line

1320 Ft. from E. Line

Ft. from W. Line

ALBERT POOL

SECTION PLAT

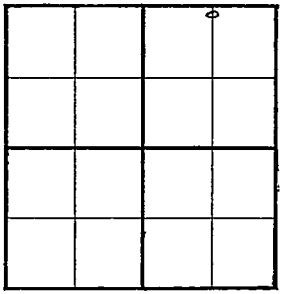

Location

Rig up

Drilling and Remarks:

16" - 250

Anhy. 998

Ream Hole 1013

RECORD

Cased in., ft.

Sand

Gas

Oil

Total Depth

PRODUCTION

1st 24 hrs. Nat.

1st 24 hrs. after shot

Gas Cu. Ft.

Dry Hole

Abandoned

Date

OCT 1 1940 19

S. J. LEWIS Scout

Form 26—200 Bks.—1-40—Palace Rush KANSAS .

Map No. 74 Sec. 36 Twp. 18 R. 16W

Well No. 4 Schroeder

Schermerhorn Company

Contractor

COMPLETED

C N L NE

330 Ft. from N. Line


Ft. from S. Line

1320 Ft. from E. Line

Ft. from W. Line

ALBERT POOL

SECTION PLAT

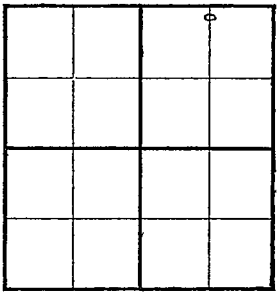

Location

Rig up

Drilling and Remarks:

Reagan 3591
TWC 3588

Depth P & A 1400

RECORD

Cased in., ft.

Sand

Gas

Oil

Total Depth 3601

PRODUCTION

1st 24 hrs. Nat.

1st 24 hrs. after shot

Gas Cu. Ft.

Dry Hole

Abandoned

Date

NOV 13 1940 19

S I LEWIS Scout