


ELK

Map No. Kansas Sec. 34 Twp. 31 R. 10

Well No. 1 Lucas Farm _____
Empire Company

_____ Ft. from N. Line
660 Ft. from S. Line
660 Ft. from E. Line
_____ Ft. from W. Line

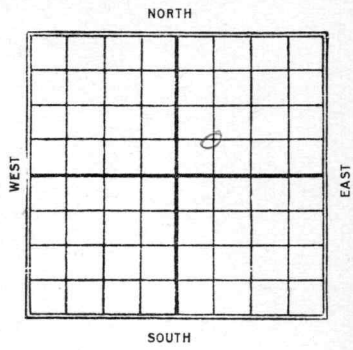

Date
1927
1/8

REPORT

Sand 200 2-19
40 gts 20 bbls
D. & G. 2350

4 KANSAS
Map No. _____ Sec. 34 Twp. 31 R. 10
Well No. 1 hisco
Empire

Company

Contractor

FIRST REPORTS

SECTION PLAT

Ft. from N. Line

660

Ft. from S. Line

Ft. from E. Line

660

Ft. from W. Line

COMPLETED

		o	
ABANDONED			

Location _____

Rig up _____

Drilling and Remarks:

Hand 2002-2019
44 est 20 lbs
DQ 5
2350

RECORD

Cased _____ in., _____ ft.

Sand _____

Gas _____

Oil _____

Total Depth 2350

PRODUCTION

1st 24 hrs. Nat. _____

1st 24 hrs. after shot _____

Gas _____ Cu. Ft.

Dry Hole ✓

Abandoned ✓

Date

JAN 8 1927

192

CHAS. L. SHERWOOD

Scout