

ELK

Map No. Kansas Sec. 34 Twp. 31 R. 10


Well No. 1 Lisco Farm _____
Theta Oil Company

320 Ft. from N. Line

_____ Ft. from S. Line

990 Ft. from E. Line

_____ Ft. from W. Line

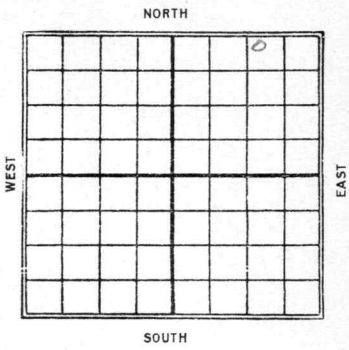

Date 1927 REPORT

1/8 Sand 2283-85
100 bbls 25 Gravity

4614 *E*

Map No. *4* KANSAS Sec. *34* Twp. *31* R. *10*

Well No. *1* *Wilcox*
Shelby Oil Co Company

Contractor

FIRST REPORTS

SECTION PLAT

330 Ft. from N. Line
Ft. from S. Line
990 Ft. from E. Line
Ft. from W. Line

			<i>0</i>

COMPLETED

Location

Rig up

Drilling and Remarks:

Wilcox Sand

100 lbs.

25 gravity

RECORD

Cased *2283-2285* in., *2285* ft.
Sand *2283-2285*
Gas
Oil
Total Depth *2285*

PRODUCTION

1st 24 hrs. Nat. _____
1st 24 hrs. after shot _____
Gas _____ Cu. Ft.
Dry Hole _____
Abandoned _____

Date JAN 8 1927

CHAS. L. SHERWOOD
Scout