

Rush

KANSAS

Section 36 Township 18 Range 16WWell Number 2 Schroder (Schroeder)

?

Company Schermerhorn


SPECIAL

NORTH

WEST

EAST

SOUTH

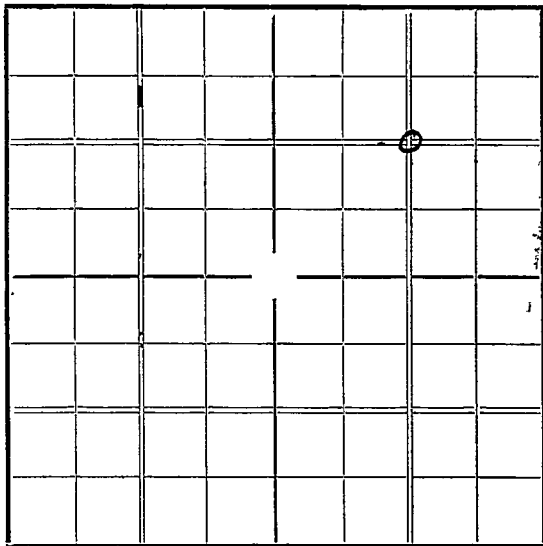

Sec. 36 Twp. 18 R. 16-W

Well No. # 2 Schroder Farm \_\_\_\_\_

# Schiermerhoen

Company


NORTH

1320 Ft. from N. Line

Ft. from S. Line

1320 Ft. from E. Line

Ft. from W. Line

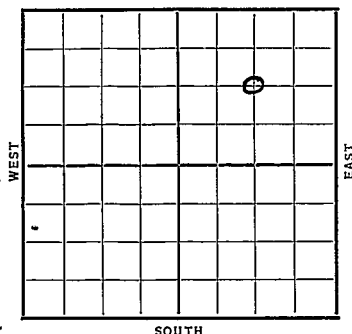

## Special

| Date  | Elev.                         | REPORT         |
|-------|-------------------------------|----------------|
| 1936  | 2013                          |                |
| 11/18 | Rig                           |                |
| 11/27 | Rigging up                    |                |
| 12/3  | No report.                    |                |
| 12/10 | Rigging up                    |                |
| 12/17 | " "                           | 12/24--12/29-- |
| 1937  | /                             |                |
| 1/7   | 15" @ 463'.                   | Drlg. 650'.    |
| 1/14  | Drlg. 1050'.                  |                |
| 1/21  | Anhydrate 1030'. 12" @ 1032'  |                |
|       | Drlg. 1950'.                  |                |
| 1/28  | 10" @ 2402'.                  | Drlg. 2420'.   |
| 2/4   | 10" @ 2462                    | Drlg. 2620'    |
| 2/11  | Drlg. 3230                    |                |
| 2/19  | 8" @ 3387.                    | Drlg. 3418'    |
| 2/26  | Drlg. 3534'.                  |                |
| 3/4   | Conglomerate 3566'            |                |
|       | Sand 3661. Show oil 3631-40'  |                |
| 3/11  | Show oil 3645'-48'. 4 bailers |                |
|       | water 3656 to 57' TD.         |                |
|       | Plug back.                    |                |
|       |                               | OVER           |

1937 .

2013

3/13 Regan sand 3651'.

Sil. 3640'.

Lansing 3330'.

T. D. 3657'.


P. B. 3353'.

Potential 267.

COMPLETED

**KANSAS** *Rush.*Map No. 74 Sec. 36 Twp. 18 R. 16WWell No. 2. SchroederSchroeder & Co. O & G Company

Contractor

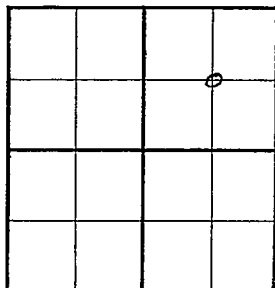**SECTION PLAT**1320 Ft. from N. Line

\_\_\_\_\_ Ft. from S. Line

1320 Ft. from E. Line

\_\_\_\_\_ Ft. from W. Line

**COMPLETE**

Location \_\_\_\_\_

Rig up \_\_\_\_\_

Drilling and Remarks:

*Regan Sand**3651**Sil 3640**Lansing 3330**P.B 3353**Potential 267***RECORD**

Cased \_\_\_\_\_ in., \_\_\_\_\_ ft.

Sand \_\_\_\_\_

Gas \_\_\_\_\_

Oil \_\_\_\_\_

Total Depth 3657**PRODUCTION**

1st 24 hrs. Nat. \_\_\_\_\_

1st 24 hrs. after shot \_\_\_\_\_

Gas \_\_\_\_\_ Cu. Ft.

Dry Hole \_\_\_\_\_

Abandoned \_\_\_\_\_

Date

MAR 17 1937

19

S. J. LEWIS Scout

**KANSAS**Map No. 74 Sec. 36 Twp. 18 R. 16WWell No. 2 SchroederSchroeder Company


Contractor

**Special**1320 Ft. from N. Line

\_\_\_\_\_ Ft. from S. Line

1320 Ft. from E. Line

\_\_\_\_\_ Ft. from W. Line

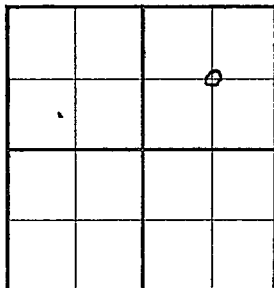**SECTION PLAT****FIRST REPORT**

Location \_\_\_\_\_

Rig up \_\_\_\_\_

Drilling and Remarks:

Rig**RECORD**

Cased \_\_\_\_\_ in., \_\_\_\_\_ ft.

Sand \_\_\_\_\_

Gas \_\_\_\_\_

Oil \_\_\_\_\_

Total Depth \_\_\_\_\_

**PRODUCTION**

1st 24 hrs. Nat. \_\_\_\_\_

1st 24 hrs. after shot \_\_\_\_\_

Gas \_\_\_\_\_ Cu. Ft.

Dry Hole \_\_\_\_\_

Abandoned \_\_\_\_\_

Date

NOV 18 1936

19

S. J. LEWIS Scout