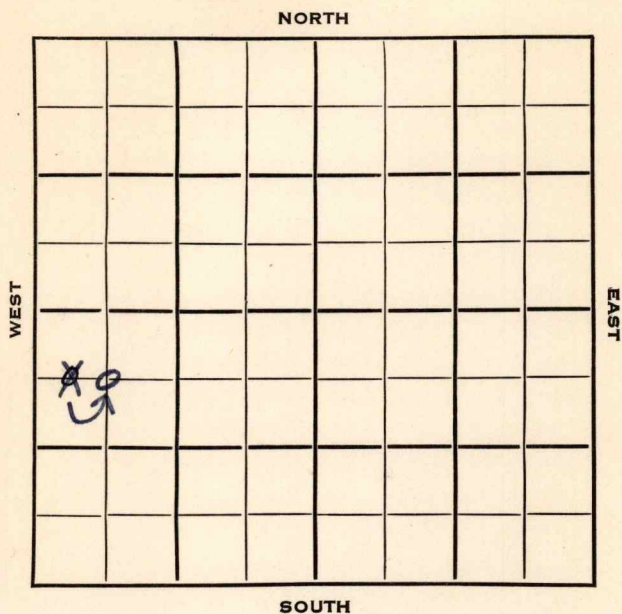


Section 36 Township 28 Range 5EWell No. 2 SooterCompany White & Ellis et al

KANSAS ✓

Butler

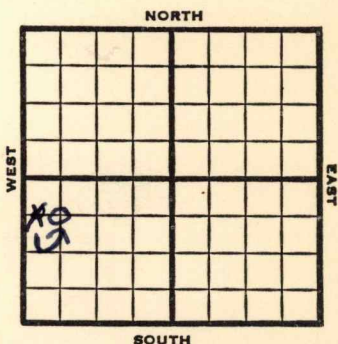
Sec. 36 Twp. 28 R. 5EWell No. #2 Sooter FarmWhite & Ellis et al CompanyWhite & Ellis Contr. Contractor

Fox Bush Pool

660 Ft. from N. Line

Ft. from S. Line

Ft. from E. Line

660
330 Ft. from W. Line~~C W L NW SW~~
C NW SW

1953

Elev. 1339

REPORT

1/7

Spudding Date 12/31/52
8" @ 102 Drlg. 2700

1/14

Spud 12-31-52

D&A

TD 2823

8" @ 102

Miss 2775

TD 2823

D&A

ABANDONED

140320

Map No. _____ Sec. 36 Twp. 28 R. 5EWell No. 1 SooterWhite & Ellis Company**CORRECTION**

Contractor

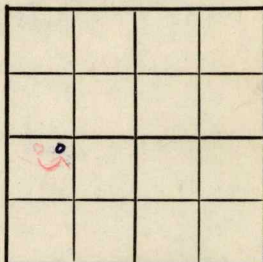
NE NW SW

SECTION PLAT

330 Ft. from N. Line

_____ Ft. from S. Line

_____ Ft. from E. Line

990 Ft. from W. LineButler County

Location _____

Rig up _____

Drilling and Remarks:

Recorrected
from

C N L NW SW

RECORD

Cased _____ in., _____ ft.

Sand _____

Gas _____

Oil _____

Total Depth _____

PRODUCTION

1st 24 hrs. Nat. _____

1st 24 hrs. after shot _____

Gas _____ Cu. Ft.

Dry Hole _____

Abandoned _____

Date

APR 15 1953

19

I. G. McGEHEE

Scout

County Butler State KansasSec. 36 (Blk. Twp.) 28 (Sur. Rge.) 5E Map No.Operator White & Ellis et al.Well No. 2 Farm SooterElev. 1339 Location C W L NW SW

660 Ft. From N Line SW330 Ft. From W Line Quarter1st. Report JAN 7 1953

Completion _____

Remarks _____

White & Ellis - Contr.Spudding Date 12-31-52Drlg. Data Fox-Bush Pool8" @ 102 drlg. 2700

