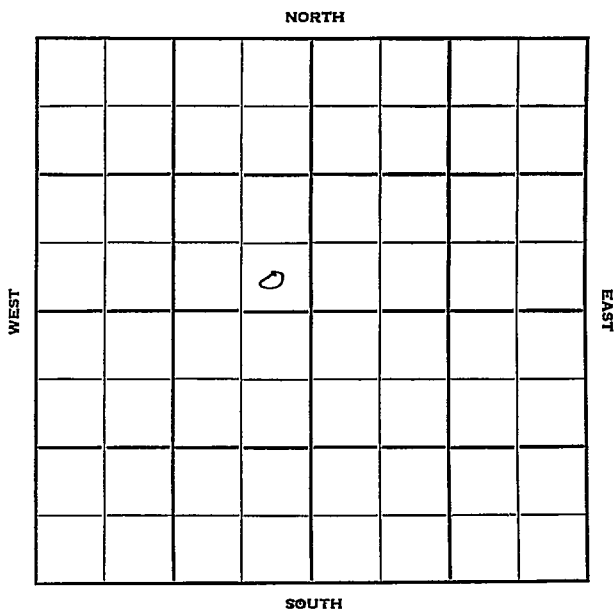


Section 28 Township 18 Range 17WWell No. #1 PetersonCompany E. H. Adair

Rush

**KANSAS**

Sec. 28 Twp. 18 R. 17W

Well No. #1 Peterson Farm

E. H. Adair Company

Adair - Contr. Contractor

# Wildcat


Ft. from N. Line

330' Ft. from S. Line

330 Ft. from E. Line

Ft. from W. Line

SE SE NW

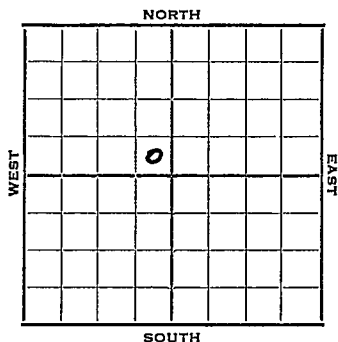

1952 | Elev. 1977 | REPORT

6/11 Spud 6-8-52

811 @ 855

WOC

6/18 | Drlg 2937'

6/25 - Howard 3017' Topeka 3078' Heeh 3336'

Br li 3374'    Lans. 3391'    Marm 3626'

Cong. 3713: Arb. 3726:

DST 3736-55, 1 hr, 445' oil 1000#

5" @ 3758' TD

7/2 CO 3754 132/3732-54 S/1 BOPH 500 A

S/17 BOPH for 4 hrs. tub & rods

7/9 | NPL

7/17 11

7/23 | Spud 6-8-52

Oil Well TD 3758

8" @ 855 Marm 3626

Cong 3713 Arb. 3726

DST 3736-55 opn 1 hr.

Rec. 445' oil 1000#

5" @ 3758 Howard 3017


Top 3078      Heeb. 3336

Br Lime 3374, Lans. 3391

CO to 3754 132/3732-54 S/1 boph


500 A S/17 boph Comp. 259 bopd

8% wtr.
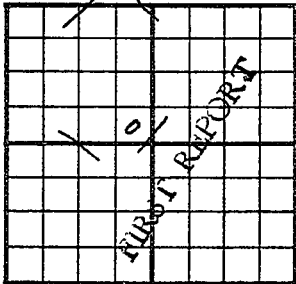
|                                                                                  |             |                  |                                                 |                  |                |
|----------------------------------------------------------------------------------|-------------|------------------|-------------------------------------------------|------------------|----------------|
| County                                                                           | Rush        |                  | State                                           | KANSAS           |                |
| Sec.                                                                             | 28          | (Blk.)<br>(Twp.) | 18                                              | (Sur.)<br>(Rge.) | 17W Map No.    |
| Operator                                                                         | E. H. Adair |                  |                                                 |                  |                |
| Well No.                                                                         | 1           | Farm             | Peterson                                        |                  |                |
| Elev.                                                                            | Location    |                  | SE SE NW                                        |                  |                |
|  |             |                  | 330                                             | Ft. From         | S Line NW      |
|                                                                                  |             |                  | 330                                             | Ft. From         | E Line Quarter |
|                                                                                  |             |                  | 1st. Report JUN 11 1952                         |                  |                |
|                                                                                  |             |                  | Completion                                      |                  |                |
|                                                                                  |             |                  | Remarks Ohio & Skelly support<br>Adair - Contr. |                  |                |
| Spudding Date                                                                    |             |                  | 6-8-52                                          |                  |                |
| Drlg. Data                                                                       |             |                  | Wildcat                                         |                  |                |
| 8" @ 855 WOC                                                                     |             |                  |                                                 |                  |                |

J. G. McGEHEE

County Rush State Kansas  
 Sec. 28 (Blk.) 18 (Sur.) 17W Map No.  
 Operator E. H. Adair  
 Well No. 1 Farm Peterson  
 Elev. 1977 Location SE SE NW

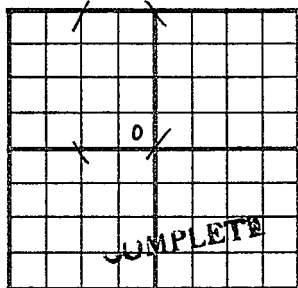

330Ft. From S Line NW  
330Ft. From E Line Quarter  
 Ist. Report  
 Completion JUL 23 1952  
 Remarks Wildcat  
Adair - Contr.  
 Spudding Date 6-8-52

Drilg. Data Oil well TD 3758  
8" @ 855 Marm. 3626 Cong. 3713  
Arb. 3726 DST 3736-55 open 1 hr.  
Rec. 445' oil 1000 # 5" @ 3758  
Howard 3017 Top. 3078 Heeb. 3336  
Br. lime 3374 Lans. 3391 CO to 3754  
132/ 3732-54 S/ 1 boph 500 A  
S/ 17 boph Comp. 259 bopd 8% water

J. G. McGEHEE