


#22 hole #2

26979

23-23-10E

23 23S 10E
 Sec. 23 Twp. 23S Rge. 10E
 Map 41187 No. 22#2
 Mid. Kansas Company
 Riv. T.O.
 Tag No.

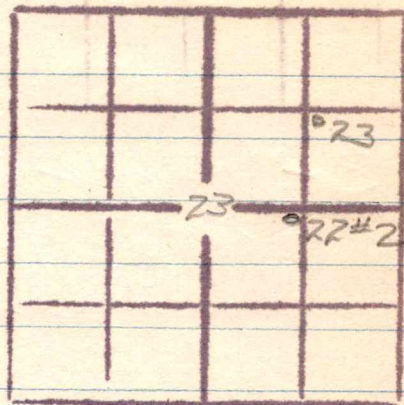

comp - 6-20-25
 comp 7-21-25
 prod 270 bbls

15-130
 12-700
 10-1220
 8-1712
 6-2064

sail 0-2
 L 3

Blsl 50

sd sh 106 wth

sh 135

L 137

sl 147

sh 165

L 175

sh 180

L 185

sh 200

L 235

sh 240

L 245

sl 300

L 310

sh 375

L 395

sl 405

sh 475

L 490

sh 550

L 555

sh 575

L 580

sl 595

L 600

sh 620

L 630

sh 645

L 650

sh 685

L

sh

L

sh

L

sh

L

sh

L

sh

L

sh

L

wth

sh

L

sd

L

sh

L

sh

L

sh

L

sh

L

wh coop

sh

L

sh

L

690

700

705

750

755

770

805

815

825

850

855

990

995

1040 HFW

1137

1195

1200 HFW

1275

1395

1425

1430

1505

1525

1560

1690

1708

1725

1730

1760

1770

over