


Section 1 Township 28 Range 6-E

Well No. #3 McCullough

Company Nat'l Refg.

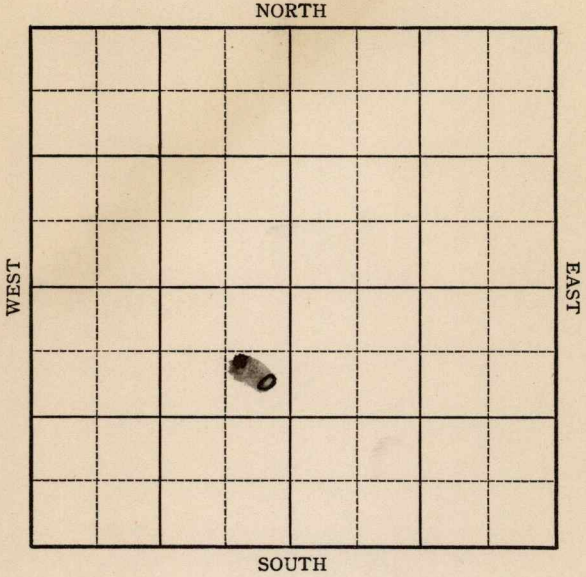

Sec. 1 Twp. 28 R. 6-E

Well No. #3 McCullough Farm


Nat'l Refg. Company

990 Ft. from N. Line

         Ft. from S. Line

330 Ft. from E. Line

         Ft. from W. Line

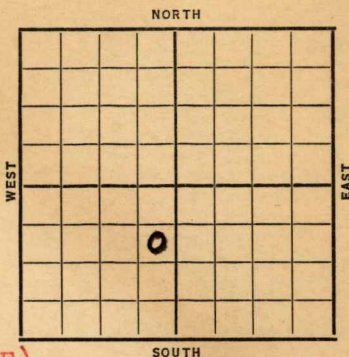

**Elev. 1428 (Est DF)**

Date	REPORT
1937	
9/22	Location
10/2	Mat.
10/8	R U M
10/15	15" @ 305'. Drlg. 835'.
10/22	12" @ 1025'. Drlg. 1415'.
10/29	10" h @ 1871'. Drlg. 1990'.
11/5	8" @ 2274'. <b>Miss. 2765'.</b> T.D. 2767' SD for pipe.
11/12	2 B.W. 2780-90'. Drlg. 2955'.
11/19	<b>Wilcox 3173'.</b> T.D. 3181'. 400' oil 1 hr. 2000' oil. Total fill-up.
11/23	<b>Wilcox 3173'.</b> T.D. 3181'. Potential 394 bbls.
	<b>COMPLETED</b>

Butler KANSAS

Map No. 11 Sec. 1 Twp. 28 R. 6 E

Well No. 3 McCullough

Natl. Refg.

Company

Contractor

FIRST REPORT

SECTION PLAT

990 Ft. from N. Line

\_\_\_\_\_ Ft. from S. Line

330 Ft. from E. Line

\_\_\_\_\_ Ft. from W. Line

		○	

Location

Rig up \_\_\_\_\_

Drilling and Remarks:

RECORD

Cased \_\_\_\_\_ in., \_\_\_\_\_ ft.

Sand \_\_\_\_\_

Gas \_\_\_\_\_

Oil \_\_\_\_\_

Total Depth \_\_\_\_\_

PRODUCTION

1st 24 hrs. Nat. \_\_\_\_\_

1st 24 hrs. after shot \_\_\_\_\_

Gas \_\_\_\_\_ Cu. Ft.

Dry Hole \_\_\_\_\_

Abandoned \_\_\_\_\_

Date

SEP 22 1937

19

H. D. Hatfield Scout

Map No. 11 Sec. 1 Twp. 28 R. 6E

Well No. 3 McCullough

National Refining Company

Contractor

**COMPLETED**

**SECTION PLAT**

**SE NE SW**

990 Ft. from N. Line

\_\_\_\_\_ Ft. from S. Line

330 Ft. from E. Line

\_\_\_\_\_ Ft. from W. Line


Location \_\_\_\_\_

Rig up \_\_\_\_\_

Drilling and Remarks:

*PT-394*

**RECORD**

Cased \_\_\_\_\_ in., \_\_\_\_\_ ft.

Sand Wilcox 3173

Gas \_\_\_\_\_

Oil \_\_\_\_\_

Total Depth 3181

**PRODUCTION**

1st 24 hrs. Nat. \_\_\_\_\_

1st 24 hrs. after shot \_\_\_\_\_

Gas \_\_\_\_\_ Cu. Ft.

Dry Hole \_\_\_\_\_

Abandoned \_\_\_\_\_

Date

NOV 23 1937

H. D. Hatfield Scout