


Section 1 Township 28 Range 6-E

Well No. 5 McCullough

Company National Refining

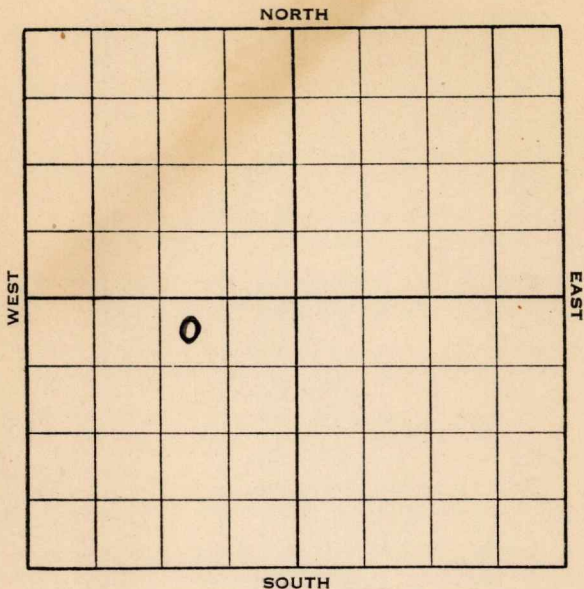

Butler

KANSAS

Map No. 11 Sec. 1 Twp. 28 R. 6E

Well No. 5 McCullough

National Refining Company

Contractor

FIRST REPORT

SECTION PLAT

NW NE SW
330 Ft. from N. Line
 _____ Ft. from S. Line
990 Ft. from E. Line
 _____ Ft. from W. Line

	0		

Location _____

Rig up _____

Drilling and Remarks:
Ponds

RECORD

Cased _____ in., _____ ft.

Sand _____

Gas _____

Oil _____

Total Depth _____

PRODUCTION

1st 24 hrs. Nat. _____

1st 24 hrs. after shot _____

Gas _____ Cu. Ft.

Dry Hole _____

Abandoned _____

Date

JUN 8 - 1938 19

H. D. Hatfield Scout

Butler **KANSAS**

Map No. 11 Sec. 1 Twp. 28 R. 6E

Well No. 5 McCullough

National Refining Company

Contractor

ABANDONED

SECTION PLAT

NW NE SW

330 Ft. from N. Line

_____ Ft. from S. Line

990 Ft. from E. Line

_____ Ft. from W. Line

	0		

Location _____

Rig up _____

Drilling and Remarks:

show sulphur w/ter

D & A

RECORD

Cased 7 in., 2920 ft.

Sand Arb 3185

Gas _____

Oil _____

Total Depth 3187

PRODUCTION

1st 24 hrs. Nat. _____

1st 24 hrs. after shot _____

Gas _____ Cu. Ft.

Dry Hole _____

Abandoned _____

Date

JUL 20 1938 19 _____ H. D. Hatfield Scout