


Section 1 Township 28 Range 6-E

Well No. 4 McCullough

Company National Refining

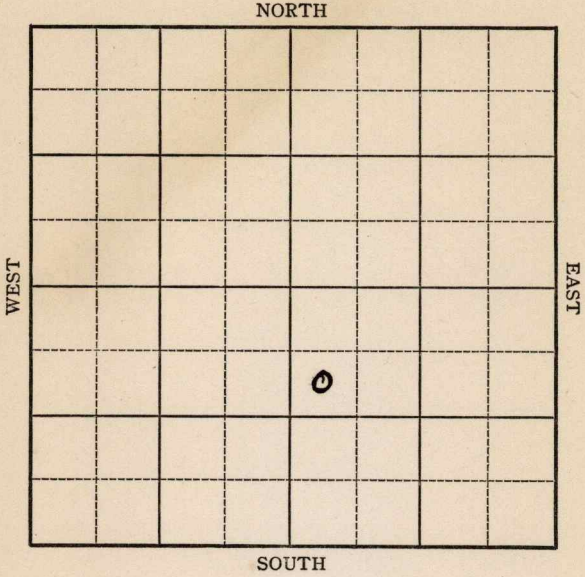

Sec. 1 Twp. 28 R. 6-E

Well No. #4 McCullough Farm

National Refining. Company


990 Ft. from N. Line

\_\_\_\_\_ Ft. from S. Line

\_\_\_\_\_ Ft. from E. Line

330 Ft. from W. Line

Elev. 1436

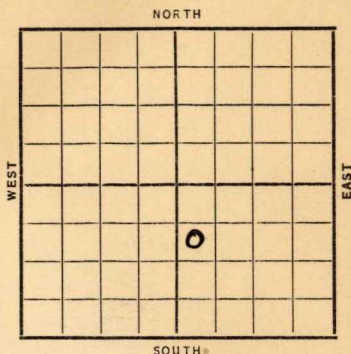

Date	REPORT
1937	
11/23	Cellar.
12/3	Spud.
12/10	15" @ 308'. Drlg. 788'.
12/17	12" @ 1016'. Drlg. 1440'.
12/24	10" @ 1865'. Drlg. 1923'.
12/31	Drlg. 2287'.
1938	
1/7	Miss. 2773'. 6" @ 2810'.
	Drlg. 3000'.
1/14	Base Miss. 3115'.
	Wilcox 3185'. T.D. 3192'.
	200' oil 48 hrs.
1/19	6" @ 3185'.
	Wilcox 3185'.
	T.D. 3197'.
	Potential 270 oil & 5 water.
	<b>COMPLETED</b>

Butler

KANSAS

Map No. 11 Sec. 1 Twp. 28 R. 6E

Well No. 4 McCullough

National Refining Company

Contractor

FIRST REPORT

SECTION PLAT

SW NW SE

990 Ft. from N. Line

\_\_\_\_\_ Ft. from S. Line

\_\_\_\_\_ Ft. from E. Line

330 Ft. from W. Line

		0	

Location \_\_\_\_\_

Rig up \_\_\_\_\_

Drilling and Remarks:

**Cellar**

RECORD

Cased \_\_\_\_\_ in., \_\_\_\_\_ ft.

Sand \_\_\_\_\_

Gas \_\_\_\_\_

Oil \_\_\_\_\_

Total Depth \_\_\_\_\_

PRODUCTION

1st 24 hrs. Nat. \_\_\_\_\_

1st 24 hrs. after shot \_\_\_\_\_

Gas \_\_\_\_\_ Cu. Ft.

Dry Hole \_\_\_\_\_

Abandoned \_\_\_\_\_

Date

NOV 23 1937

19

H. D. Hatfield

Scout

Butler

KANSAS

Map No. 11 Sec. 1 Twp. 28 R. 6E

Well No. 4 McCullough

National Refining Company

Contractor

**COMPLETED**

SW NW SE

990 Ft. from N. Line

\_\_\_\_\_ Ft. from S. Line

\_\_\_\_\_ Ft. from E. Line

330 Ft. from W. Line

**SECTION PLAT**

		0	

Location \_\_\_\_\_

Rig up \_\_\_\_\_

Drilling and Remarks:

**RECORD**

Cased 6 in., 3185 ft.

Sand Wilcox 3185

Gas \_\_\_\_\_

Oil \_\_\_\_\_

Total Depth 3197

**PRODUCTION**

1st 24 hrs. Nat. \_\_\_\_\_

1st 24 hrs. after shot \_\_\_\_\_

Gas \_\_\_\_\_ Cu. Ft.

Dry Hole \_\_\_\_\_

Abandoned \_\_\_\_\_

*Pot 270 oil  
5 water*

Date

JAN 19 1938

19

H. D. Hatfield Scout