


Section 1 Township 28 Range 6E

Well Number #2 Sutter "A"

Company National Ref.

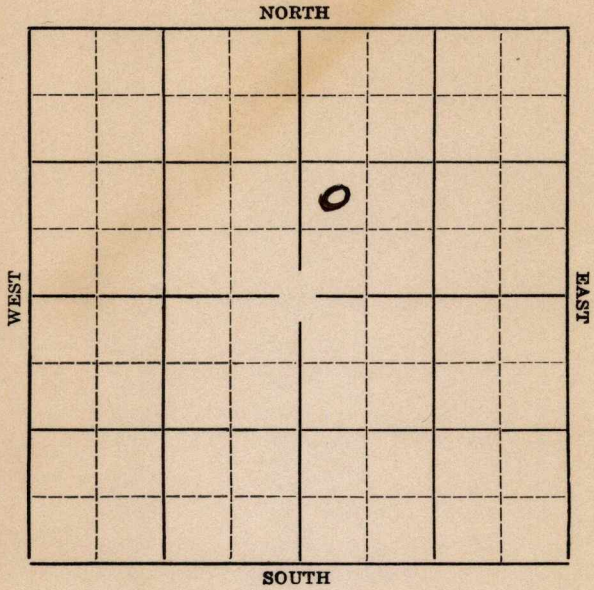

Map No. **KANSAS** Sec. **1** Twp. **28** R. **6E**

Well No. **# 2 Sutter "A"** Farm


**National Ref.** Company

\_\_\_\_\_ Ft. from N. Line

**990'** Ft. from S. Line

\_\_\_\_\_ Ft. from E. Line

**330'** Ft. from W. Line

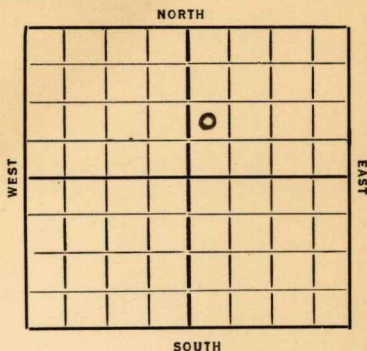

Date **1936**

REPORT

**5/20** Ponds.

**5/28** Rig on ground.

**6/4** Drlg. 475'.

**6/11** Drlg. 1400'.

**6/18** Drlg. 1925'.

**6/25** Drlg. 2685'.

**7/2** Miss. L. 2775'. Drlg. 2950'.

**7/9** B. Miss. L. 3100'. Wilcox 3168'.

**7/16** 1000 gallons of acid. Pot. 874'.

**7/23** Shot 45 qts. Clean out.

**7/29/36-Simpson 3178'**.

T.D. 3185'.

Shot 45 qts.

1000 gallons of acid.

Potential 785 bbls oil.

20% water.

**COMPLETED**

**KANSAS**

Map No. 11 Sec. 1 Twp. 28 R. 6E

Well No. 2. Sutter "A"

National Ref. Company

Contractor

**SECTION PLAT**

		o	

\_\_\_\_\_ Ft. from N. Line

990 Ft. from S. Line

\_\_\_\_\_ Ft. from E. Line

330 Ft. from W. Line

**FIRST REPORT**

Location \_\_\_\_\_

Rig up \_\_\_\_\_

Drilling and Remarks:

*Ponds*

**RECORD**

Cased \_\_\_\_\_ in., \_\_\_\_\_ ft.

Sand \_\_\_\_\_

Gas \_\_\_\_\_

Oil \_\_\_\_\_

Total Depth \_\_\_\_\_

**PRODUCTION**

1st 24 hrs. Nat. \_\_\_\_\_

1st 24 hrs. after shot \_\_\_\_\_

Gas \_\_\_\_\_ Cu. Ft

Dry Hole \_\_\_\_\_

Abandoned \_\_\_\_\_

Date

MAY 20 1936 19

S. J. LEWIS Sc

KANSAS

Map No. 11 Sec. 1 Twp. 28 R. 6E

Well No. 2 Sutter "A"

National Ref. Company

Contractor

SECTION PLAT

		0	

\_\_\_\_\_ Ft. from N. Line

990 Ft. from S. Line

\_\_\_\_\_ Ft. from E. Line

230 Ft. from W. Line

COMPLETED

Location \_\_\_\_\_

Rig up \_\_\_\_\_

Drilling and Remarks:

*Simpson 3178.*  
*Sho 4459 to .*  
*1000 acid*  
*P & 785 oil*  
*20% water.*

RECORD

Cased \_\_\_\_\_ in., \_\_\_\_\_ ft.

Sand \_\_\_\_\_

Gas \_\_\_\_\_

Oil \_\_\_\_\_

Total Depth 3186

PRODUCTION

1st 24 hrs. Nat. \_\_\_\_\_

1st 24 hrs. after shot \_\_\_\_\_

Gas \_\_\_\_\_ Cu. Ft.

Dry Hole \_\_\_\_\_

Abandoned \_\_\_\_\_

Date

JUL 29 1936

S. J. LEWIS Scout