


Map No. 15 Sec. 8 Twp. 31 R. 11E
Well No. 1-Osborne Farm
Halstead et al Company

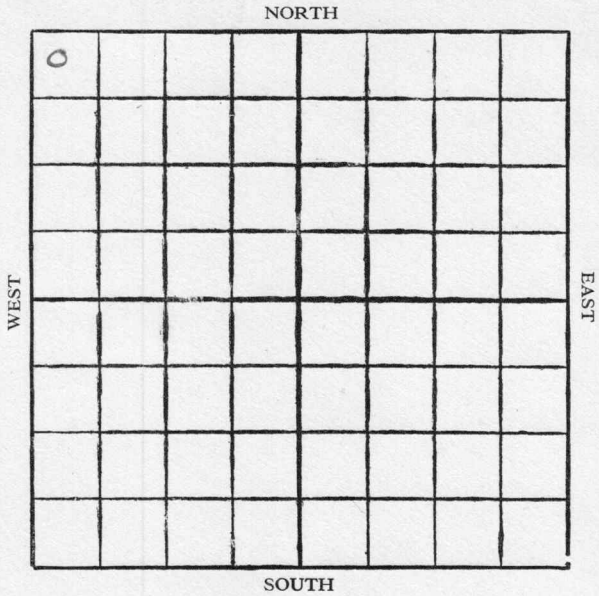

Location

Drilling Remarks

.....

.....

RECORD

Cased..... in. ft.

Sand

Gas

Oil

Total Depth.....

Rig Up.....

Drilling Remarks

.....

.....

PRODUCTION

1st 24 hrs. Nat.....

1st 24 hrs. after shot.....

Gas..... cu. ft.

Dry Hole.....

Abandoned.....

7 **KANSAS** 8 **Elks** 31 **R. 11^W**
 Map No. ----- Sec. ----- Twp. ----- R. -----
 Well No. **1 Osborne** -----
Halstead et al ----- Company

----- Contractor

FIRST REPORTS

SECTION PLAT

200 Ft. from N. Line

 Ft. from S. Line

 Ft. from E. Line
200 Ft. from W. Line

0			
ABANDONED			

COMPLETED

Location -----

Rig up -----

Drilling and Remarks:

Th 1904
2nd Break 2200

RECORD

Cased ----- in., ----- ft.
 Sand -----
 Gas -----
 Oil -----
 Total Depth **2988**

PRODUCTION

1st 24 hrs. Nat. -----
 1st 24 hrs. after shot -----
 Gas ----- Cu. Ft.
 Dry Hole -----
 Abandoned -----

Date

JAN. 8 1927

CHAS. L. SHERWOOD

----- 192

----- Scout