KANSAS


Form 51—5M—4-36—Palace

Butler

Section 1 Township 28 Range 6-E

Well Number #4 Sutter "A"

Company National Ref.

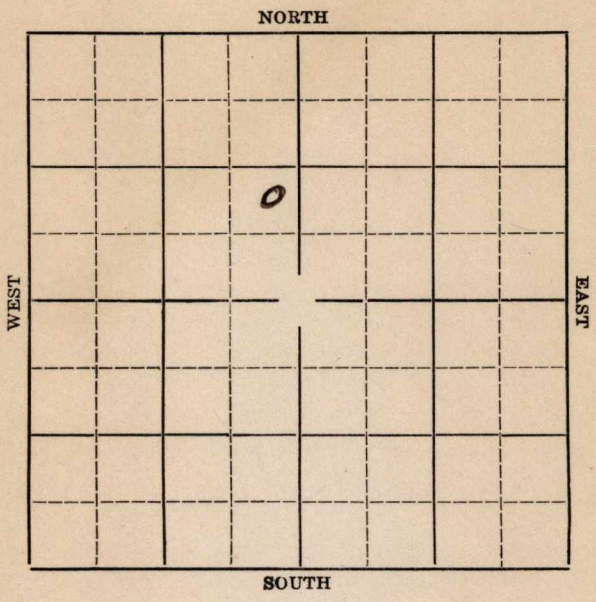


Form 252-A—5M—7-36—Palace KANSAS Butler

Sec. 1 Twp. 28 R. 6-E

Well No. 4 Sutter A Farm

National Ref. Company

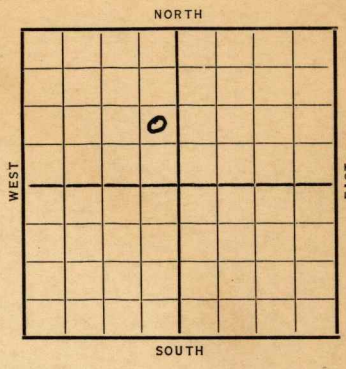

_____ Ft. from N. Line

990 Ft. from S. Line

330 Ft. from E. Line

_____ Ft. from W. Line

Elev. 1439

Date 1936	REPORT
11/4	Location
11/12--11/19--	
11/27	Rigging up
12/3	15" @ 310'. Drlg. 315'.
12/10	12" @ 1043'. Drlg. 1200'.
12/17	10" @ 1860'. Drlg. 1885'.
12/24	K. C. L. 2109'. 8" @ 2284'. Drlg. 2750'.
12/29	Miss. L. 2770'. 6" @ 2773'. Drlg. 2940'.
1937	
1/7	T. D. 3150'. Shut down.
1/14	Wilcox 3172'. Pay 3173-85' T.D 1500' oil 10 hours. Shot 50 qts Clean out.
1/21	" "
1/28	" "
2/4	" "
2/11	" "
2/18	" "
2/26	Plug back to 3100'.

OVER

1937

3/4 Plug back to 3100'.

3/11 " " "

3/18 Drlg. 3170'.

3/25 T.D. 3184'. Pump 20 oil
34 water.

4/2 " " " "

4/7 Wilcox 3173'.
T. D. 3184'.
Shot 50 qts.
Potential 186 oil, 1% water.

COMPLETED

Form 26 1M Dkg 2-29

KANSAS


Map No. 11 Sec. 1 Twp. 28 R. 6E

Well No. 4 Sutter "A"

National Ref. Company

Contractor

SECTION PLAT

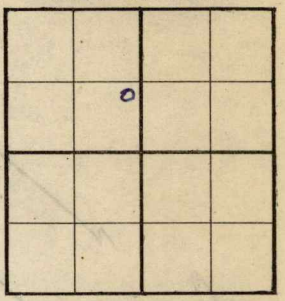

Ft. from N. Line

990 Ft. from S. Line

330 Ft. from E. Line

Ft. from W. Line

FIRST REPORT

Location

Rig up

Drilling and Remarks:

RECORD

Cased in., ft.

Sand

Gas

Oil

Total Depth

PRODUCTION

1st 24 hrs. Nat.

1st 24 hrs. after shot

Gas Cu. Ft.

Dry Hole

Abandoned

Date

NOV 4 1936 19

S. J. LEWIS Scout

Form 26—1M Bks.—2-29 KANSAS Butler


Map No. 11 Sec. 1 Twp. 28 R. 6E

Well No. 4 Sutter "A"

National Ref. Company

Contractor

SECTION PLAT

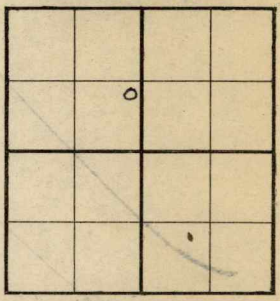

_____ Ft. from N. Line

990 Ft. from S. Line

330 Ft. from E. Line

_____ Ft. from W. Line

COMPLETED

Location _____

Rig up _____

Drilling and Remarks:

Ohio Cop 3173

Shot 50 qts.

Potential

186 Oil 1% water.

RECORD

Cased _____ in., _____ ft.

Sand _____

Gas _____

Oil _____

Total Depth 8184

PRODUCTION

1st 24 hrs. Nat. _____

1st 24 hrs. after shot _____

Gas _____ Cu. Ft.

Dry Hole _____

Abandoned _____

Date

APR 7 1937 19

S. J. LEWIS Scout