


Section 1 Township 28 Range 6E

Well No. 1 Sutter "B"

Company Wixson

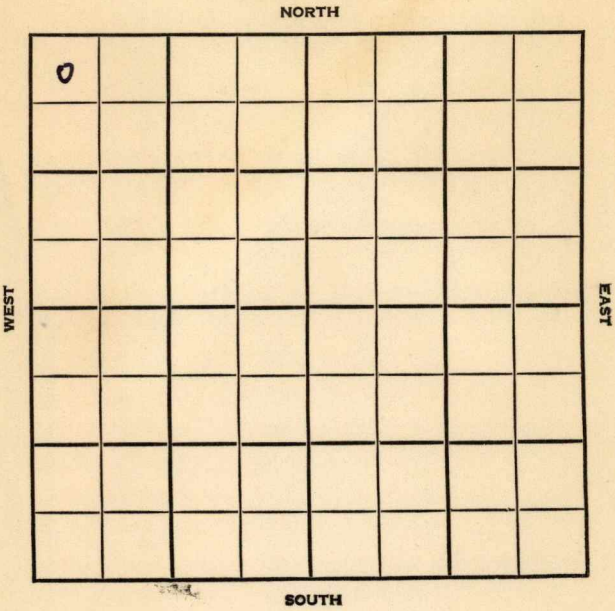

Butler

KANSAS

SEC.

TWP.

R.

1

28

6E

WELL NO.

#1 Sutter "B"

FARM

COMPANY

Wixson

CONTRACTOR

Co. Tools.

DeMoss Pool

330

Ft. from N. Line

Ft. from S. Line


Ft. from E. Line

330

Ft. from W. Line

NW NW NW

NORTH

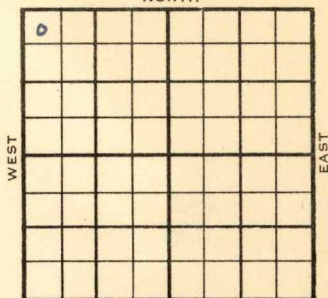

SOUTH

1955

ELEVATION

1433'

REPORT

1/19

RUST

3/2

Spud 1-19-55 D & A TD 3244

13" @ 1025 10" @ 1675

Lans 1800' KC 2130 8" @ 2255

Bart 2695' Miss 2775

7" @ 2842 Simp. 3207' Arb. 3232

TD 3244' D & A

ABANDONED

County Butler State KansasSec. 1 (Blk. Twp.) 28 (Sur. Rge.) 6E Map No.Operator WixsonWell No. 1 Farm Sutter "B"Elev. Location NW NW NW

0									

FIRST REPORT

330 Ft. From N Line NW330 Ft. From W Line Quarter

JAN 19 1955

1st. Report

Completion


Remarks

Co. tools

Spudding Date

Drlg. Data DeMoss PoolRUST

FABEN GILSTRAP

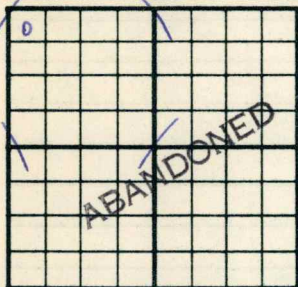County Butler State KansasSec. 1 (Blk. Twp.) 28 (Sur. Rge.) 6E Map No.Operator WixsonWell No. 1 Farm Sutter "B"Elev. 1433 Location NW NW NW330 Ft. From N Line NW330 Ft. From W Line Quarter

1st. Report

Completion MAR 2 1955Remarks DeMoss PoolCo. toolsSpudding Date 1-19-55Drlg. Data D & A TD 324413" @ 1025 10" @ 1675 Lans. 1800KC 2130 8" @ 2255 Bart. 2695Miss. 2775 7" @ 2842 Simp. 3207Arb. 3232 TD 3244D & A

FABEN GILSTRAP