


KANSAS

Section 31 Township 18 Range 10WWell No. #2 MankeCompany Sohio

NORTH

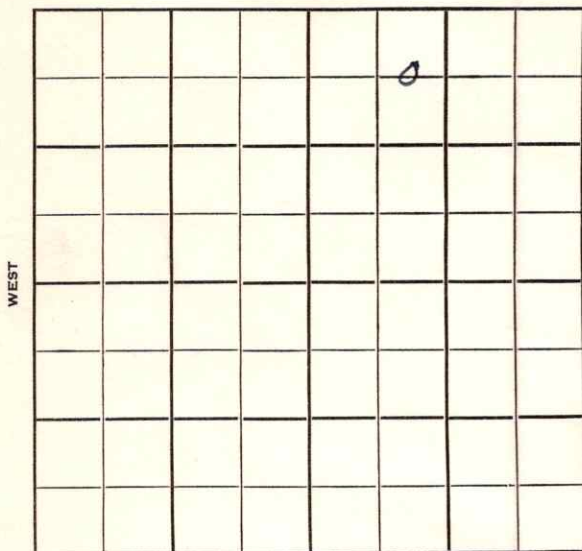

SOUTH

Rice

KANSAS

Sec. 31 Twp. 18 R. 10W

Well No. #2 Manke Farm

Sohio

Company

Murfin Drlg.

Contractor

Mary Ida Pool

660

Ft. from N. Line


Ft. from S. Line

Ft. from E. Line

990

Ft. from W. Line

C E L NW NE

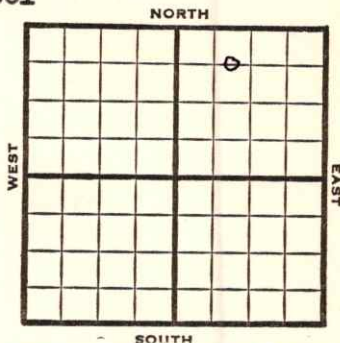

1952

Elev. 1744'

REPORT

1/2

Location

2/6

TD 3266'

5" @ 3266' POP

2/13

Spud 1-2-52

Oil Well TD 3312

8" @ 309'

Top 2554 Heeb. 2820

Br Lime 2937 Lans. 2956

DST 3038-46 opn 45 min.

Rec. 30' ho & gcm 60' gco

60' free oil

DST 3191-3205 opn 1 hr

Rec. 65' o & gcm

Arb. 3262 TD 3266

5" @ 3266 DD 3295 1 qt. oil


1 qt wph DD 3312 8 gwph & SSO

PB 3240

28/3198-3205 1000 A S/5 3/4 bfph

1% wtr Comp. 174 bopd

COMPLETED

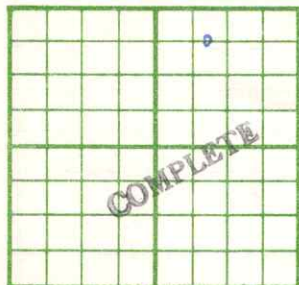County Rice State KansasSec. 31 (Blk.) 18 (Sur.) 10W Map No.Operator SohioWell No. 2 Farm MankeElev. 1744 Location C E L NW NE660 Ft. From N Line NE990 Ft. From W Line Quarter

1st. Report

Completion FEB 13 1952Remarks Mary Ida PoolMurfin Drlg. - Cntr.Spudding Date 1-2-52Drlg. Data Oil well TD 33128" @ 309 Top. 2554 Heeb. 2820Br. lime 2937 Lans. 2956 DST 3038-46open 45 min. Rec. 30' ho & gcm 60' gco60' free oil DST 3191-3205 open 1 hr.Rec. 65' o & gcm Arb. 3262 TD 32665" @ 3266 DD 3295 1 qt. oil 1 qt wphDD 3312 8 gwph & SSO PB 324028/ 3198-3205 1000 A S/ 5 3/4 bfph1% water Comp. 174 bopd

J. G. McGEHEE

County Rice State KansasSec. 31 (Blk. Twp.) 18 (Sur. Rge.) 10W Map No.Operator SohioWell No. 2 Farm MankeElev. Location C E L NW NE660 Ft. From N Line NE990 Ft. From W Line Quarter1st. Report JAN 2 1952

Completion

Remarks

Murfin Drlg. - Contr.

Spudding Date

Drlg. Data Mary Ida PoolLocation

J. E. TYRA