

Rice

Section 31 Township 18 Range 10 W

Well No. #4 Reif "A"

Company Sohio et al

NORTH

WEST	0						EAST

SOUTH

Rice

KANSAS

10W

Sec. 31

Twp. _____

18

R. _____

Well No. #4 Reif "A"

Farm _____

Sohio et al

Company _____

Penquin Drlg. - Contr.

Contractor _____

Mary Ida Pool


330' Ft. from N. Line

_____ Ft. from S. Line

_____ Ft. from E. Line

330' Ft. from W. Line

NW NW SW

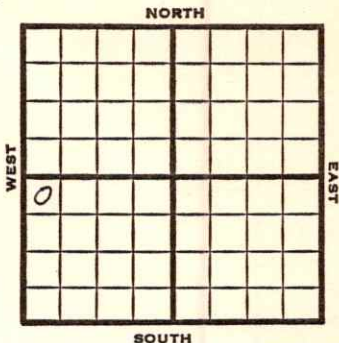

1951

Elev. 1749'

REPORT

1/31

Set Surface

Spud 1-27-51

4/4

Spud 1-27-51 Oil well TD 3272'

8" @ 293 **Top. 2545'**

DST 2748-68' open 1 hr. Rec. 30' fluid

22' SOCM, 5' HOCM, 3' free oil,

Heeb 2805', Lans 2938'

DST 3023-43 open 1 hr. Rec. 190' free oil, 210' mud & oil.

DST 3108-28 open 45 min. 155' free oil, 180' HOCM Qts/ 3259-72

5 1/2" @ 3262' TD 3272' 1 GOPH

Hydrofrac 3262-72 S/ 1-3/4 BOPH

SP 3216 56/ 3114-28 2000 A

F/ 10 1/2 BOPH S/ 25 BOPH

Comp. 428 BOPD

COMPLETED

